


LANE COUNTY

1"=400'
See Map 17 06 31

18-02

31 32

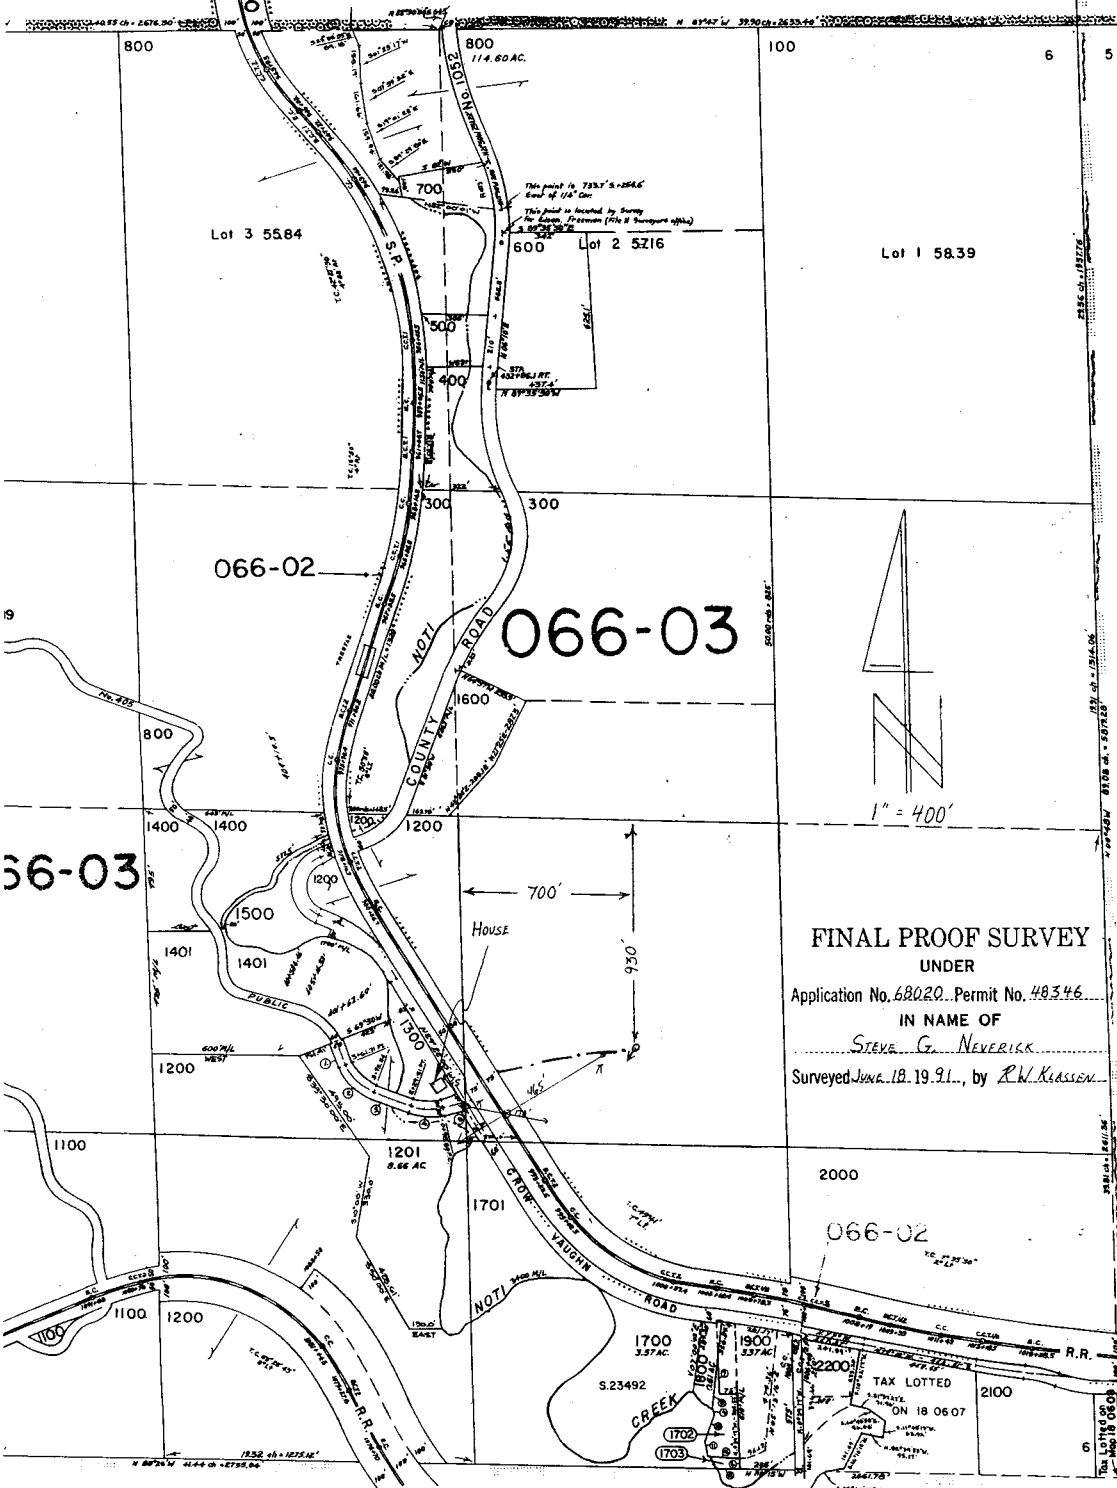

FINAL PROOF SURVEY

UNDER

Application No. 68020 Permit No. 48346

IN NAME OF

STEVE G. NEVERICK

Surveyed June 18, 1991, by R.W. KLASSEN