


T. 8 N., R. 8 W., W.M.

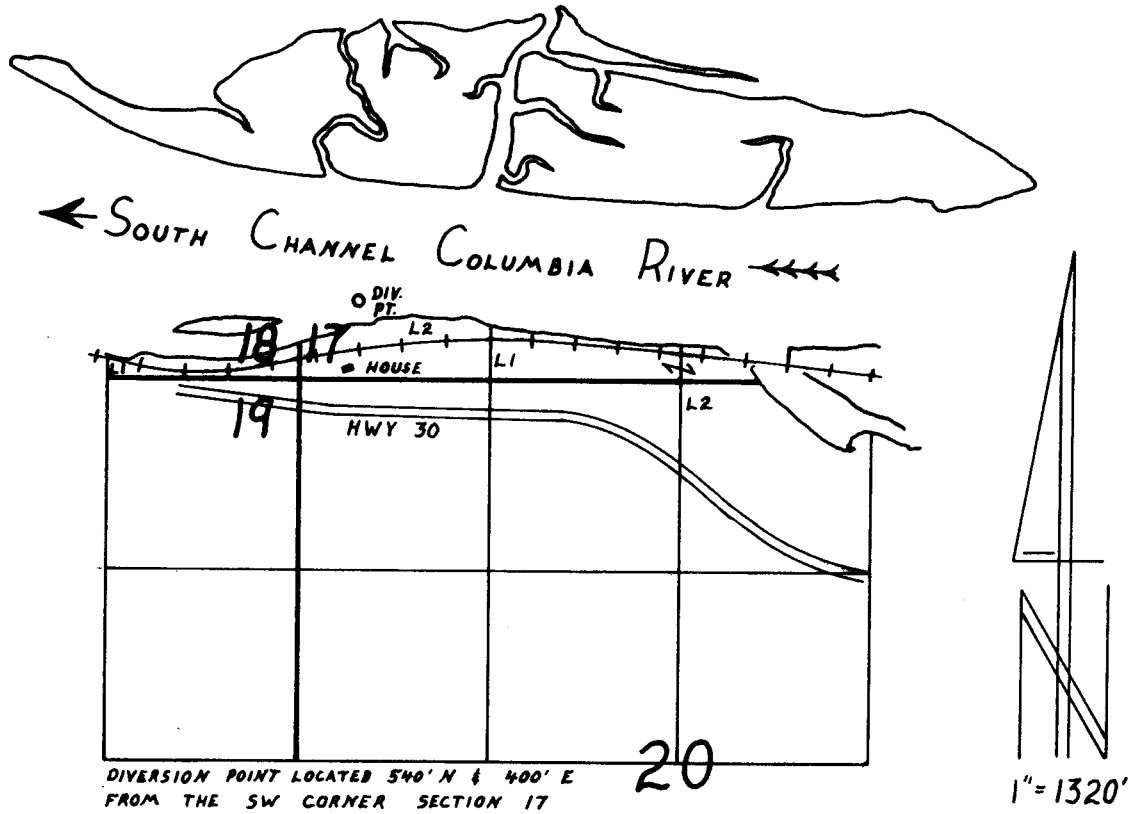

FINAL PROOF SURVEY

UNDER

Application No. 68685 Permit No. 49663
IN NAME OF

EDWARD W. LICKAR

Surveyed JULY 15, 1992, by R.W. Klassen