


Township LN,

1129

Map of Marion Allen Land

Appropriation from Five Mile Creek


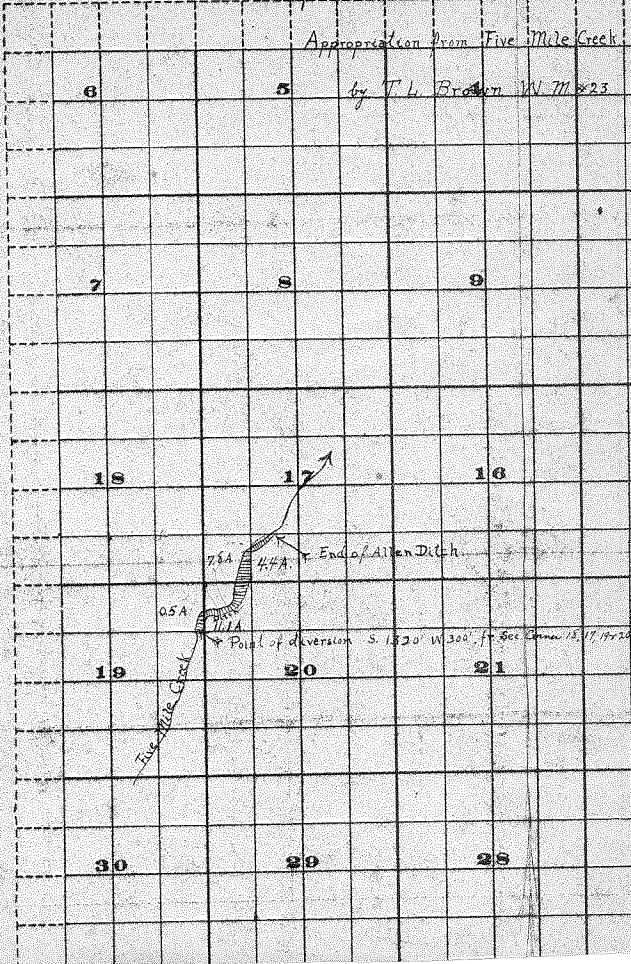

N _____, Range 14 E.

Allen Land Application No. 9511

From Five Mile Creek Wasco Co.


STATE ENGINEER
RECEIVED

MAY 15 1974

SALEM, OREGON

Application No. 9511
Permit No. 6292

