


Township 10 S., Range 30 E., W.M.

RECORDED

1993 10 25

1000000

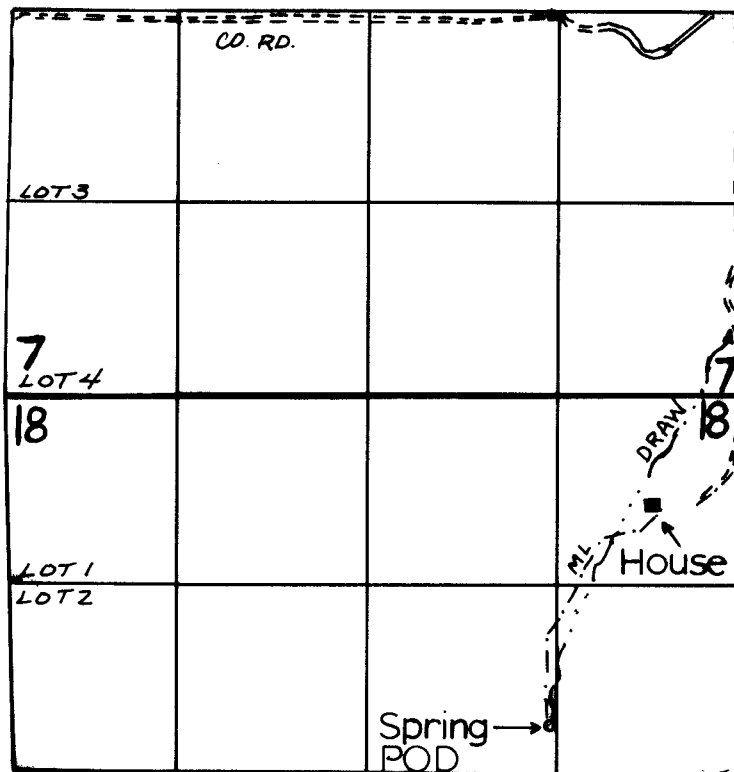

POD 2310' S. & 1370' W. FROM THE N.E. COR. SEC. 18.

1"= 1320'

**FINAL PROOF SURVEY
UNDER**

Application No.68704. Permit No.49666.....
IN NAME OF

ROBERT D. AND LINDA M. BLAKESLEE

Surveyed Sept. 28. 19..99, by J. Miller.....

NAPD 7036, 95EC 41, FOX GUARD MCD 12/27/99

GEC 4/9/03