
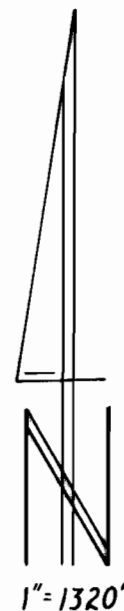


T. 17 S., R. 9 W., W.M.

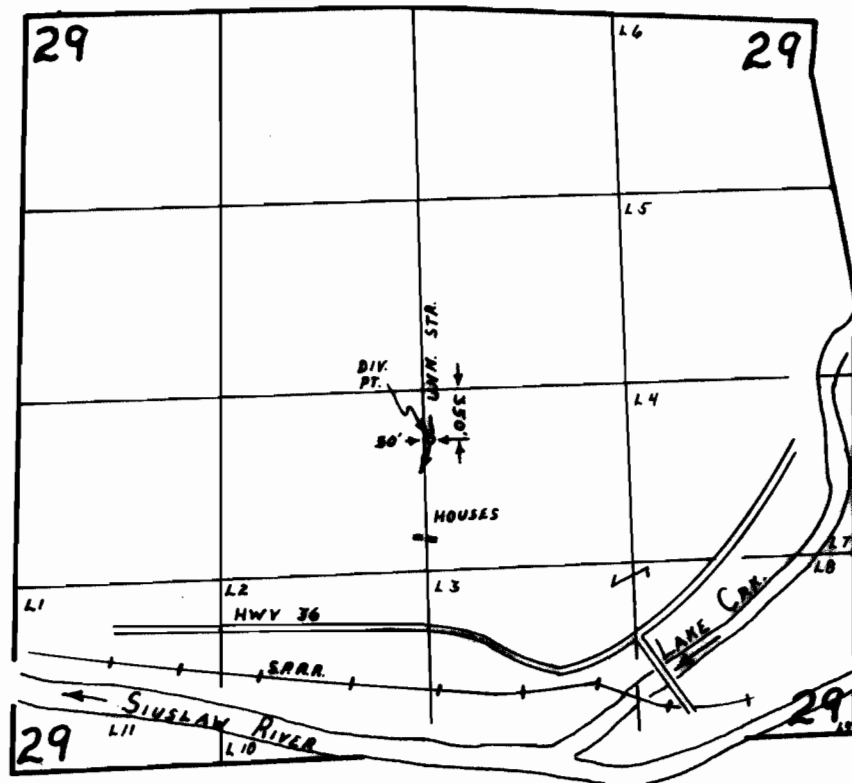

FINAL PROOF SURVEY

UNDER

Application No. 68757 Permit No. 49719
IN NAME OF

JANEY M. NORTH

Surveyed NOVEMBER 17, 1992, by R.W. Klassen