


TIN, RIOE, W.M.

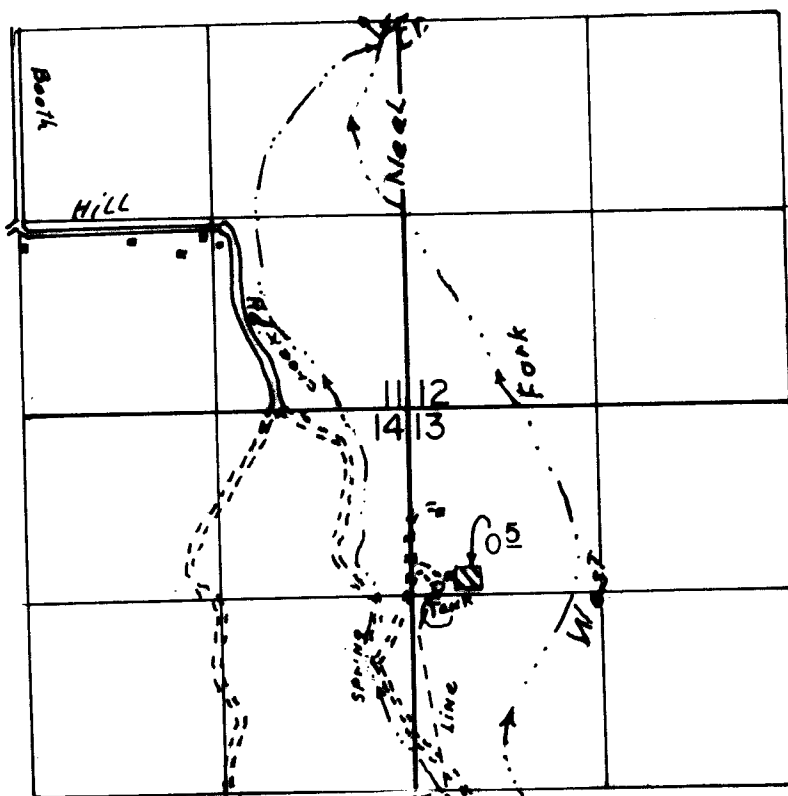

DIV. LOC: 2800'S & 260'E FROM NW COR. OF SEC 13.

SCALE 1"=1320'

FINAL PROOF SURVEY UNDER

Application No. 68967. Permit No. 49932.....
IN NAME OF

Robert V. and Janice G. Bryant

Surveyed AUG 22 1995, by R.M. SUTTERFIELD

PHOTO SURVEY 41027-180-21R

11/2/95

R.M.S.