

T. 15 S., R. 10 W., W.M.

SECTION 1

SW $\frac{1}{4}$ SE $\frac{1}{4}$

House

N $\frac{1}{4}$ Cor
Sec 12

SECTION 12

NW $\frac{1}{4}$ NE $\frac{1}{4}$

DIVERSION
POINT # 1

UNW. STR.

DIVERSION POINT 1 IS LOCATED
920' S & 870' E FROM THE
N $\frac{1}{4}$ CORNER SECTION 12

LINCOLN CO.

LANE CO.

DIVERSION
POINT # 2


UNW. STR.

DIVERSION POINT 2 IS LOCATED
1490' S & 990' E FROM THE
N $\frac{1}{4}$ CORNER SECTION 12

SW $\frac{1}{4}$ NE $\frac{1}{4}$

+ B.C.

CENTER 1/256 CORNER
NE $\frac{1}{4}$ SW $\frac{1}{4}$ NE $\frac{1}{4}$

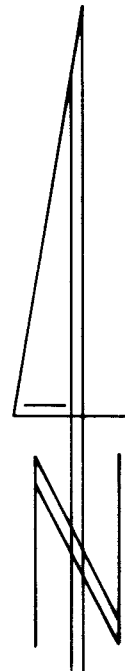

1" = 400'

FINAL PROOF SURVEY

UNDER

Application No. 69002 Permit No. 49954

IN NAME OF

TODD L. HENRICHS

Surveyed MAY 20, 1991, by R.W. Klassen