


T. 11 S., R. 20 E., W.M.

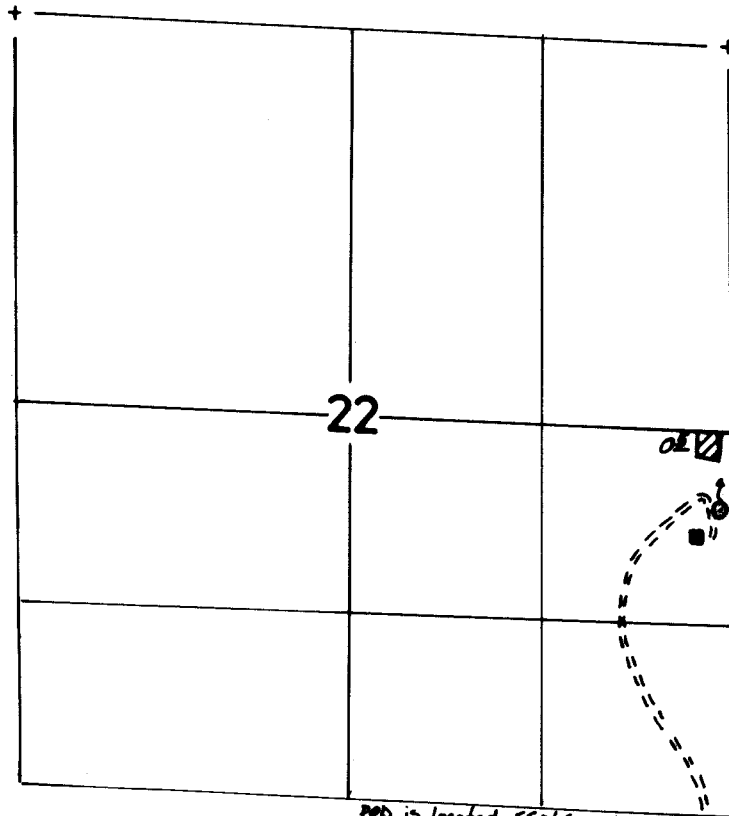

POB is located 850' South and
75' West from the East 1/4
Corner, Section 22

Spring
House

1"=1320'

FINAL PROOF SURVEY

UNDER

Application No. 60449 Permit No. 45674
IN NAME OF

TERRY SAWYER

Surveyed 9-10, 1992, by J. MILLER

BAC 4/16/2003

Lawson Mt. Quad, 41069-179-242 R 1-5-95