


RECEIVED
JUN 12 1980
WATER RESOURCES DEPT
SALEM, OREGON

T.8S. R.25E. W.M.

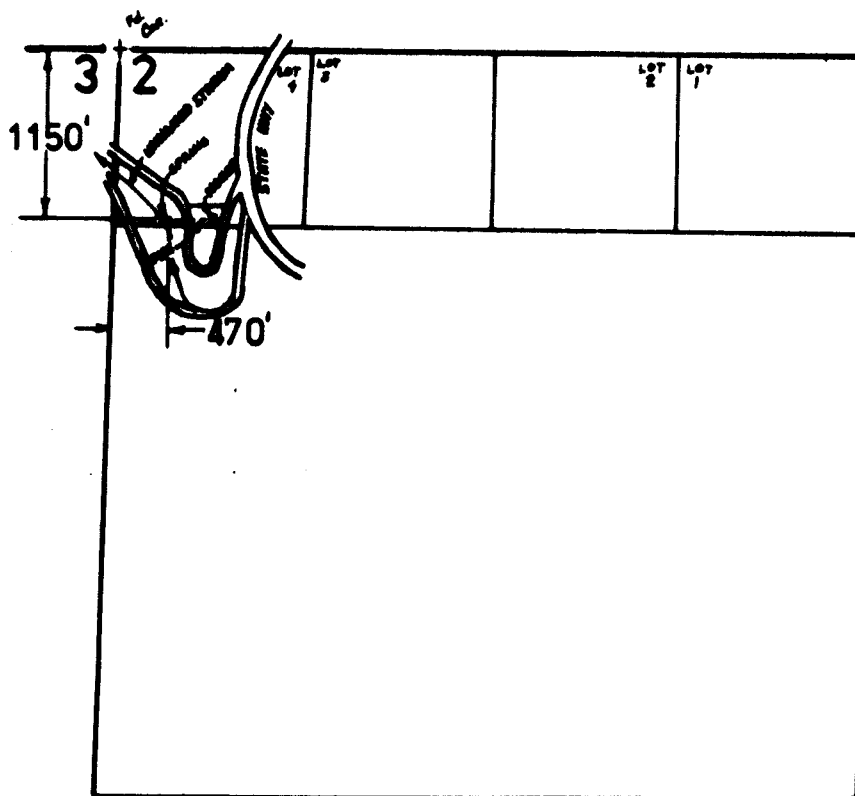

FINAL PROOF SURVEY
UNDER

Application No. 60217 Permit No. 44970
IN NAME OF

Michael Jensen

