

SECTION 29 T.7N. R.2W. W.M.

COLUMBIA COUNTY


THIS MAP HAS BEEN PREPARED FOR ASSESSMENT PURPOSES ONLY

Scale: 1" = 400' Current Revision Date: 9 / 21 / 90

7 2 2
& INDE

7 2 20 3

SEE MAP 7 2 20

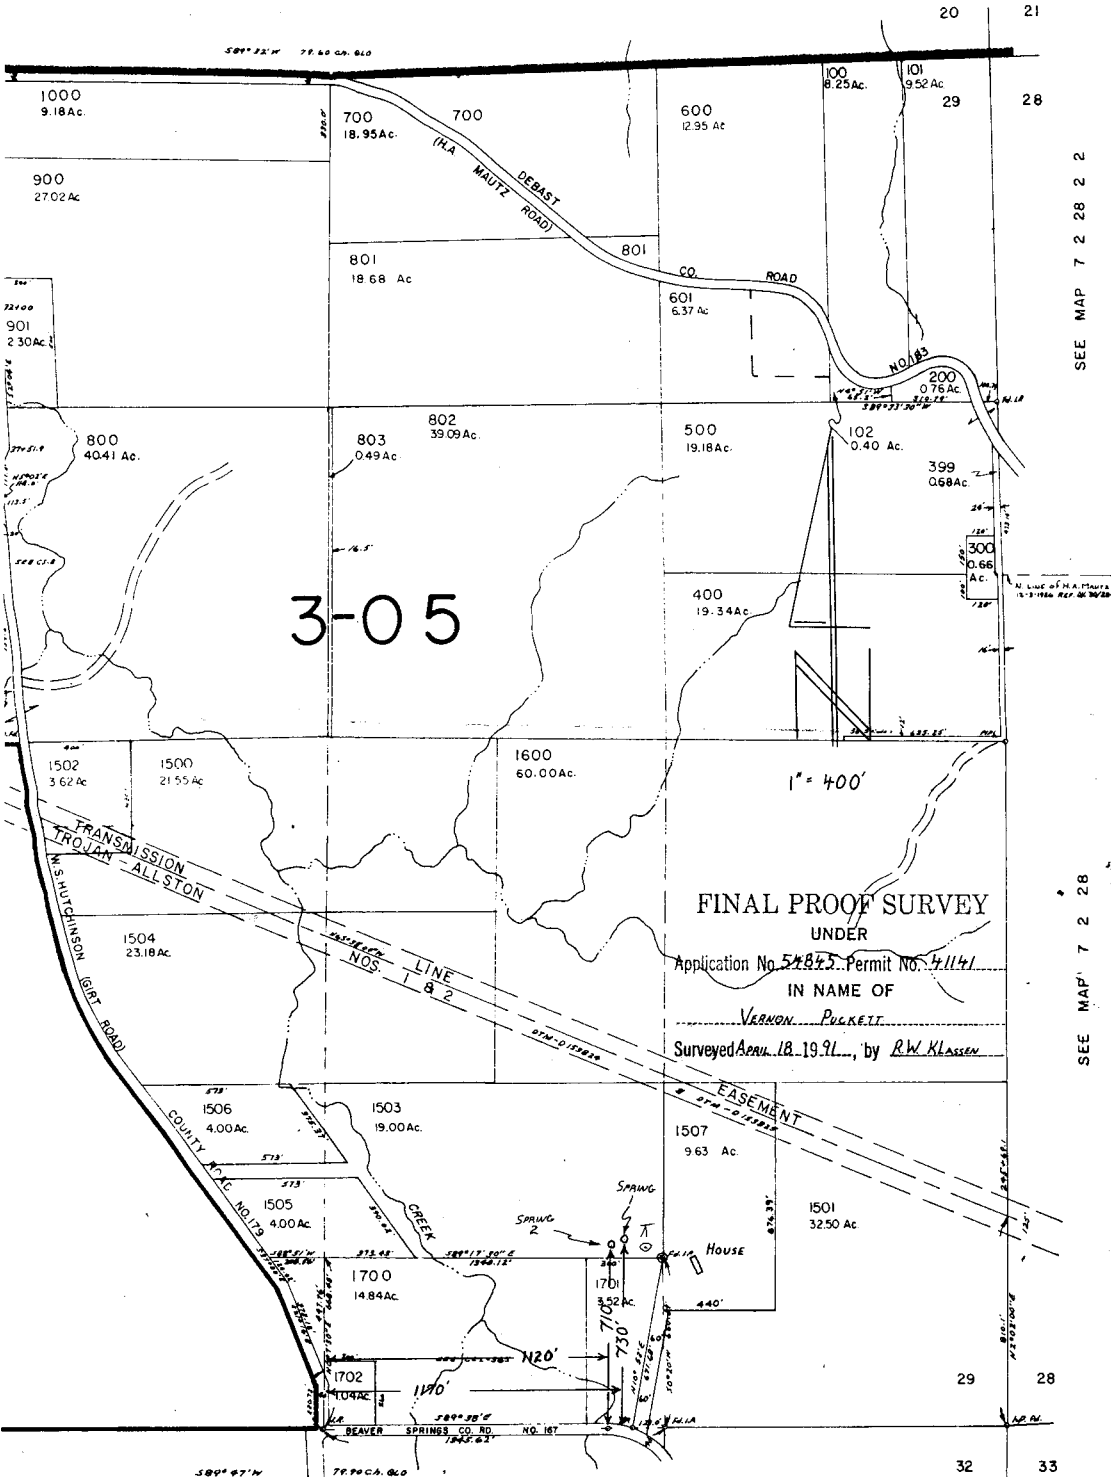

SEE MAP 7 2 28 2 2

SEE MAP 7 2 28

FINAL PROOF SURVEY UNDER

Application No. 54855 Permit No. 41141
IN NAME OF

VERNON PUCKETT

Surveyed April 18, 1991, by R.W. KLASSEN

EASEMENT

HOUSE

SEE MAP 7 2 32 1

72