


RECEIVED

JUN 15 1979

WATER RESOURCES DEPT.  
SALEM, OREGON

T.8S., R.11W., W.M.

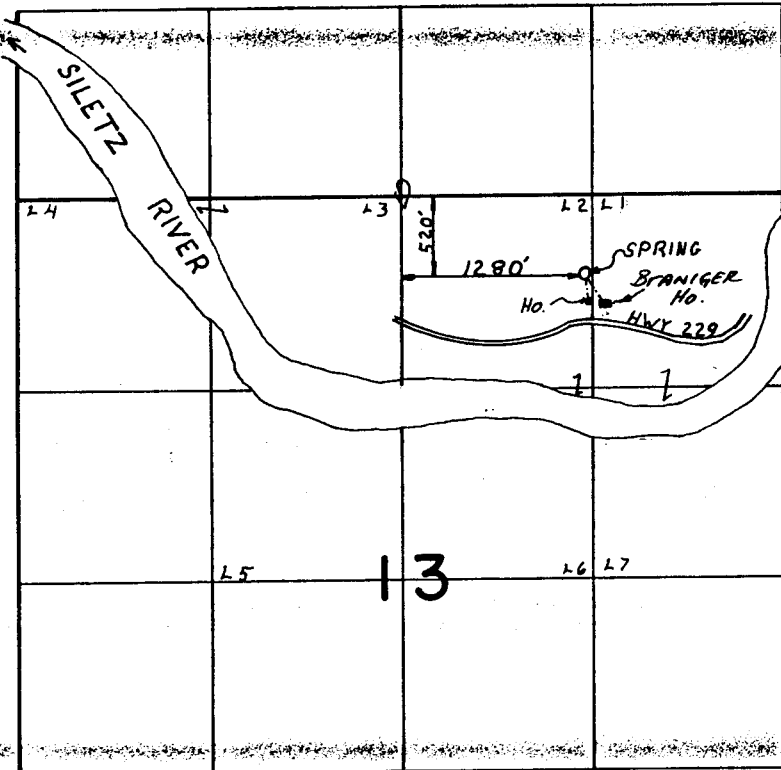

Map to Accompany Application  
for MAYDIEN BRANIGER

THIS MAP PREPARED BY:

*A.P. Applicant*

~~FINAL PROOF SURVEY~~

FROM INFORMATION FURNISHED BY  
THE APPLICANT.

UNDER

Application No. 58790

Permit No. 44342

Application No. ~~50949~~ Permit No. ~~38462~~

IN NAME OF

~~PAUL & GERALDINE WOODRUM~~

Surveyed JUNE 30 1976, by C.R. KING