
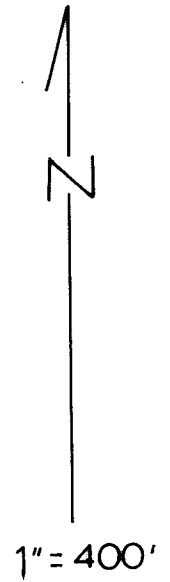


RECEIVED

AUG 4 1997

WATER RESOURCES DEPT.
SALEM, OREGON

T. 2 N., R. 10 E., W.M.

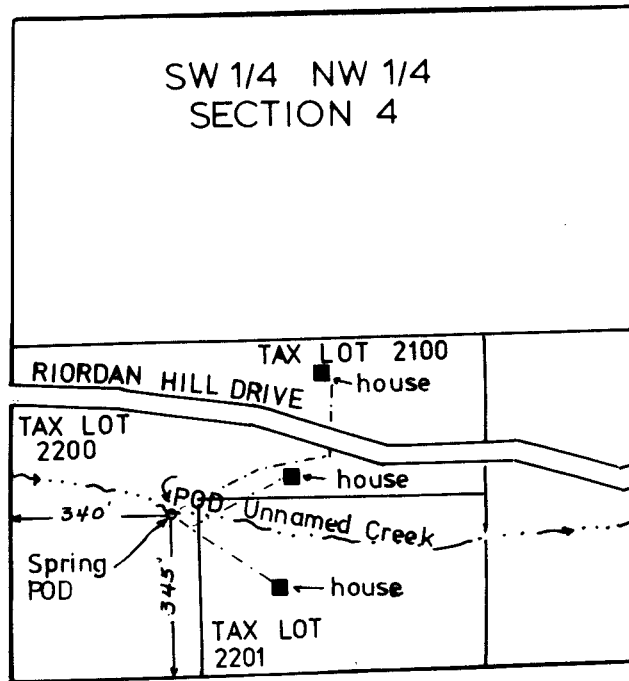

FINAL PROOF SURVEY
UNDER

Application No. 69001 Permit No. 50105
IN NAME OF

JOHN N. AND DIXIE L. FARNSWORTH
TONY W. AND MAXINE L. FREITAS
DAVID W. AND ELIZABETH THOMAS

Surveyed OCTOBER 8, 1992 by L. MILLER