


SECTION 6 T14S R9W W1
LINCOLN COUNTY

1" = 400'
See Map 13 9

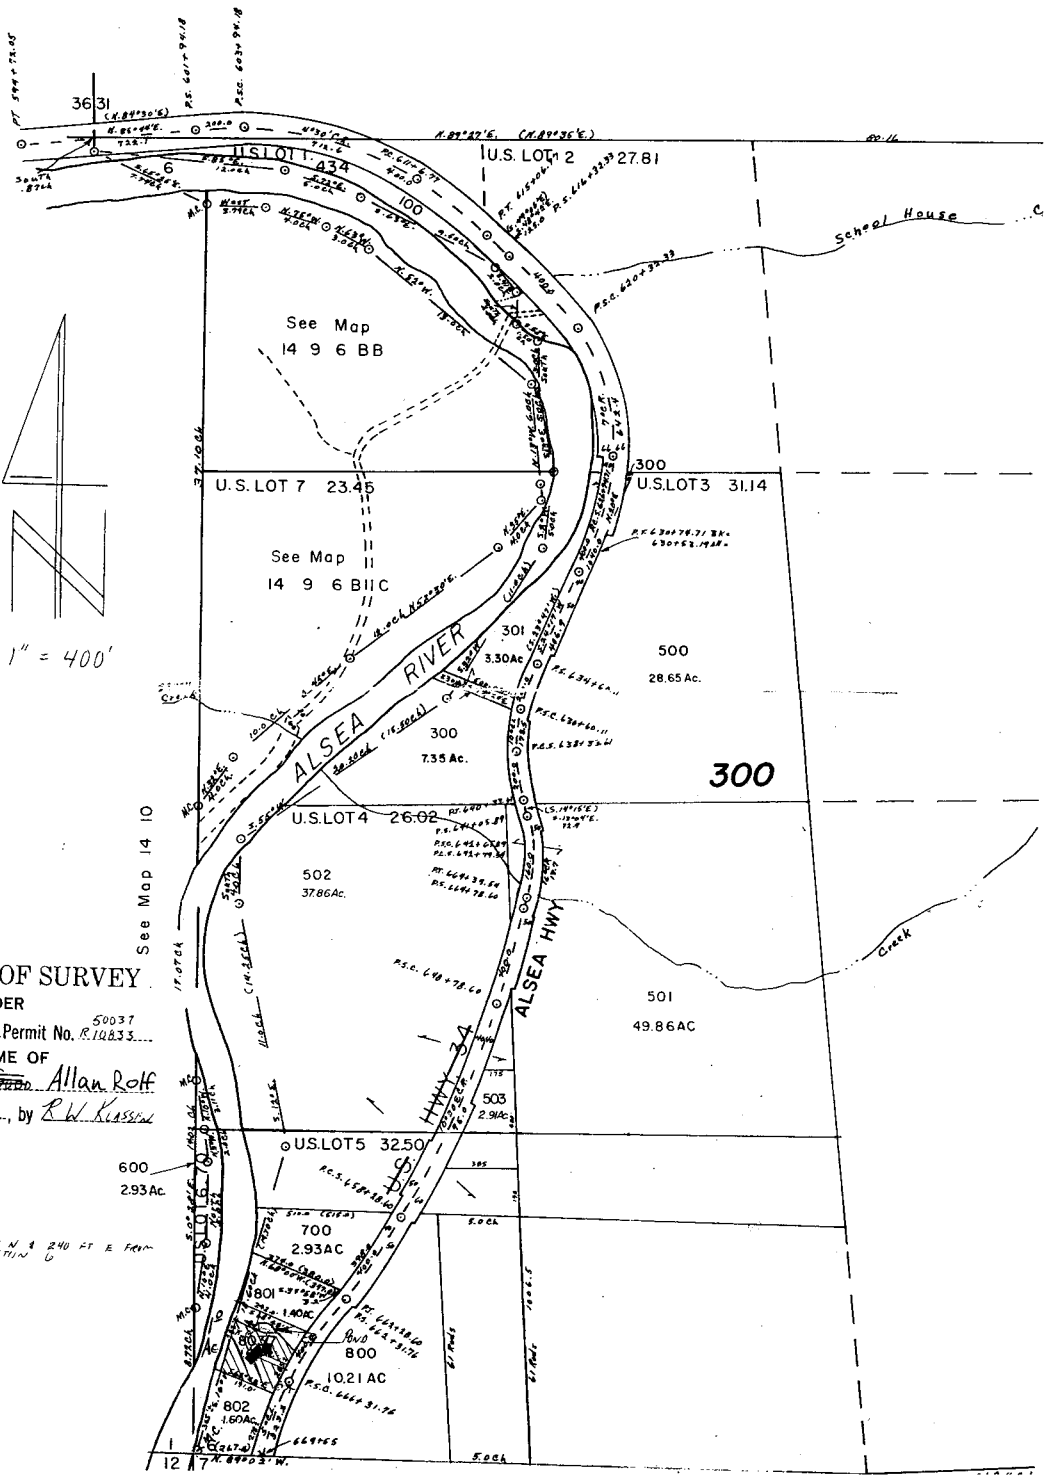

L PROOF SURVEY
UNDER
67081 50037
No. R. 26220.. Permit No. R. 14835...
IN NAME OF
John G. Allan Rolf
20.19.91., by R.W. Kassin

TUMS: 530 FT N & 240 FT E FROM
CORNER OF SECTION 6