
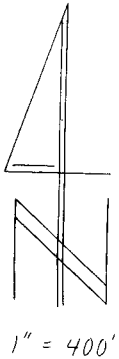


SECTION 6 T14S R9W W1
LINCOLN COUNTY

1" = 400'
See Map 13 9

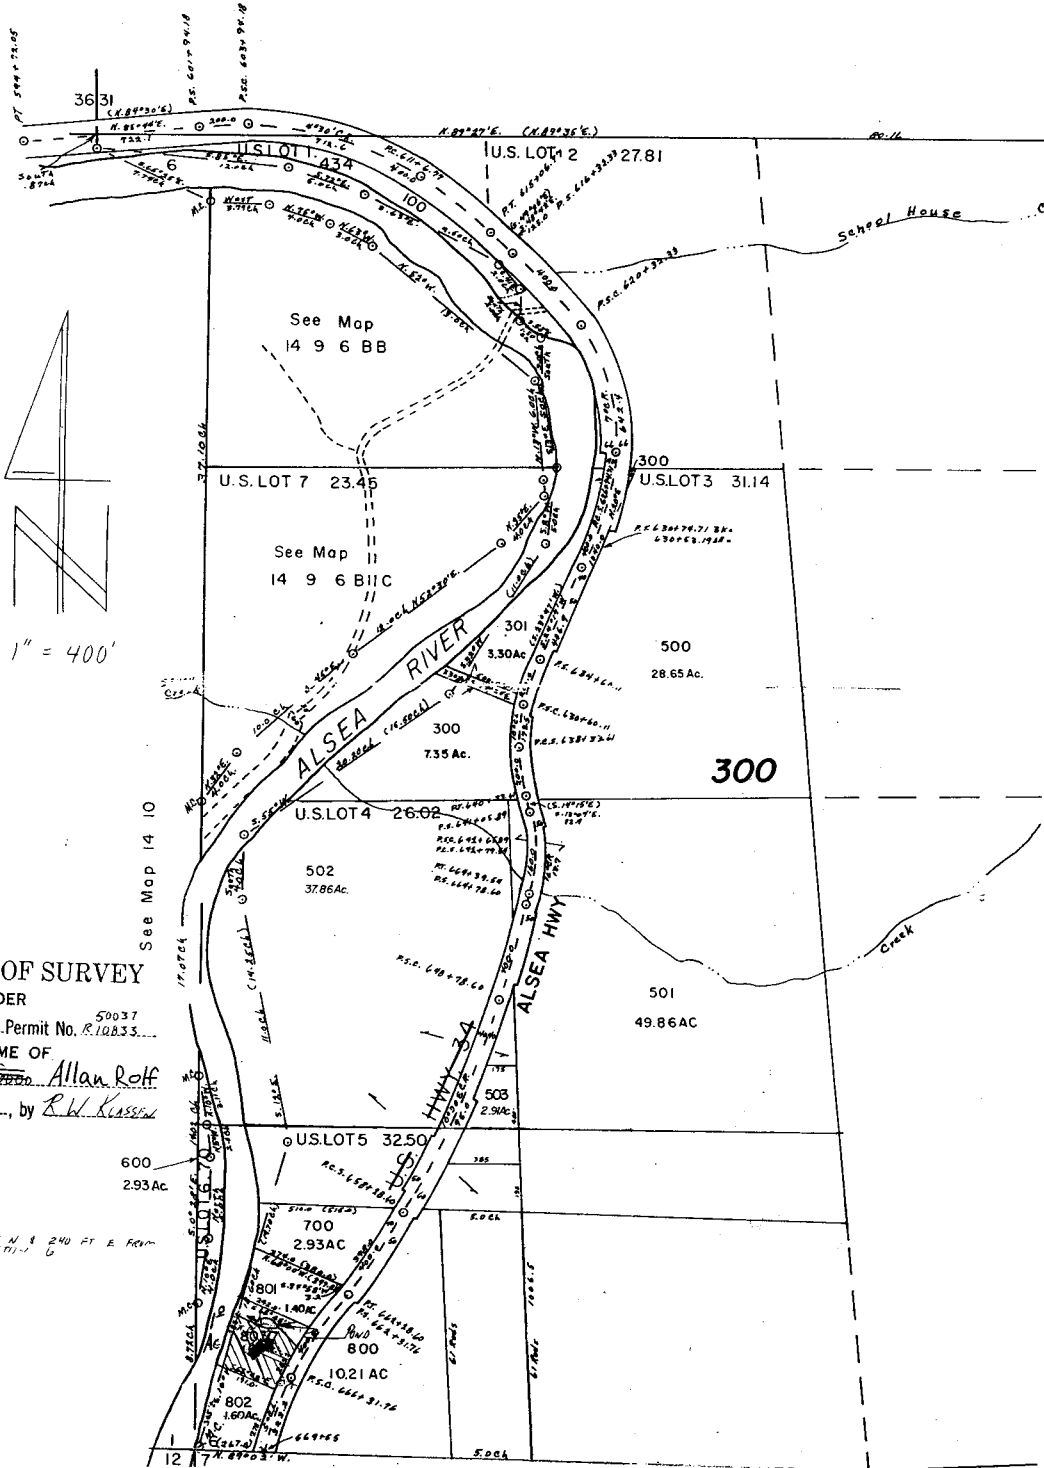

L PROOF SURVEY
UNDER
67081 50037
No. 642220 Permit No. R10833...
IN NAME OF
John Allan Rolf
20.19.91, by R.W. KASSER

TUM: 530 FT N & 240 FT E PERM
QUER OF SECTION 6