


Section 04 Township 28S Range 13W W.M.
Coos County

P.O.D. is 114' East &
234' North of N1/16
P.O.D. is a dug out Spring
with a concrete Dam 18'
long and 4' high with a
3 HP elec. submersible pump.

Prepared For: Jean-Claude Heek
Prepared By: Dennis Goude
Surveyed: 12/17/92

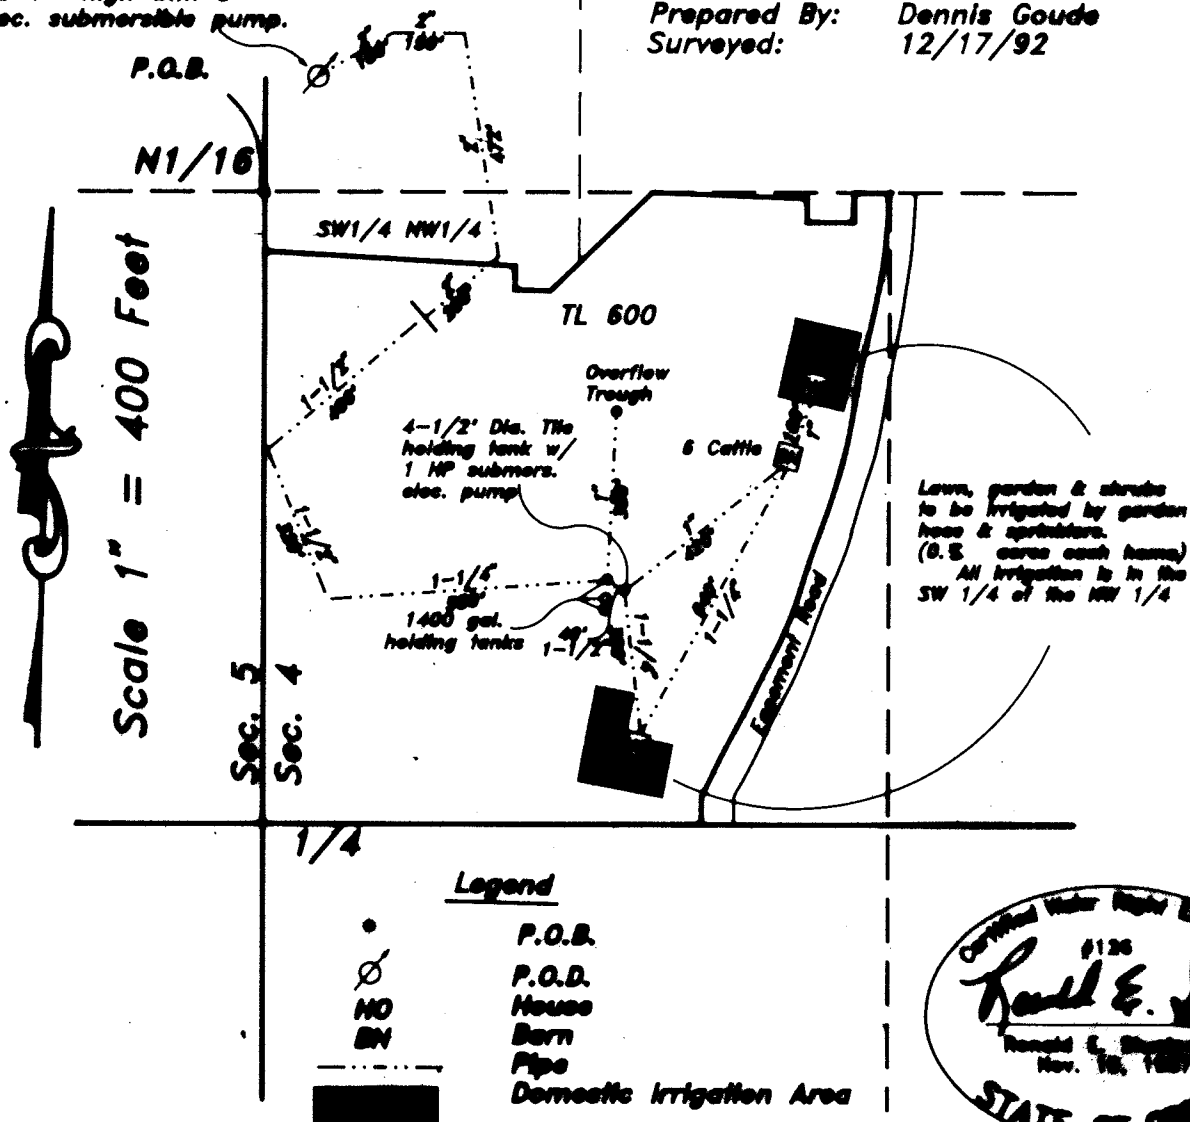

Legend

- P.O.D.
- ⊗ P.O.D.
- NO House
- BN Barn
- Pipe
- Domestic Irrigation Area

EXAMINER'S DECLARATION STATEMENT

The P.O.D. and Waterline is entirely located on property owned by the applicant.

The preparation of this map was for the purpose of identifying the location of the Water Right only and has no intent to provide dimensions or location of property ownership lines.

EXPIRES 06/30/98

FINAL PROOF SURVEY

RECEIVED

JAN 22 1997

WATER RESOURCES DEPT.
SALEM, OREGON

Application No. S-73196
Permit No. 52482




