


T. 21S., R. 28E., W.M.
HARNEY CO., ORE.

RECEIVED

SEP - 5 1997

WATER RESOURCES DEPT.
SALEM, OREGON

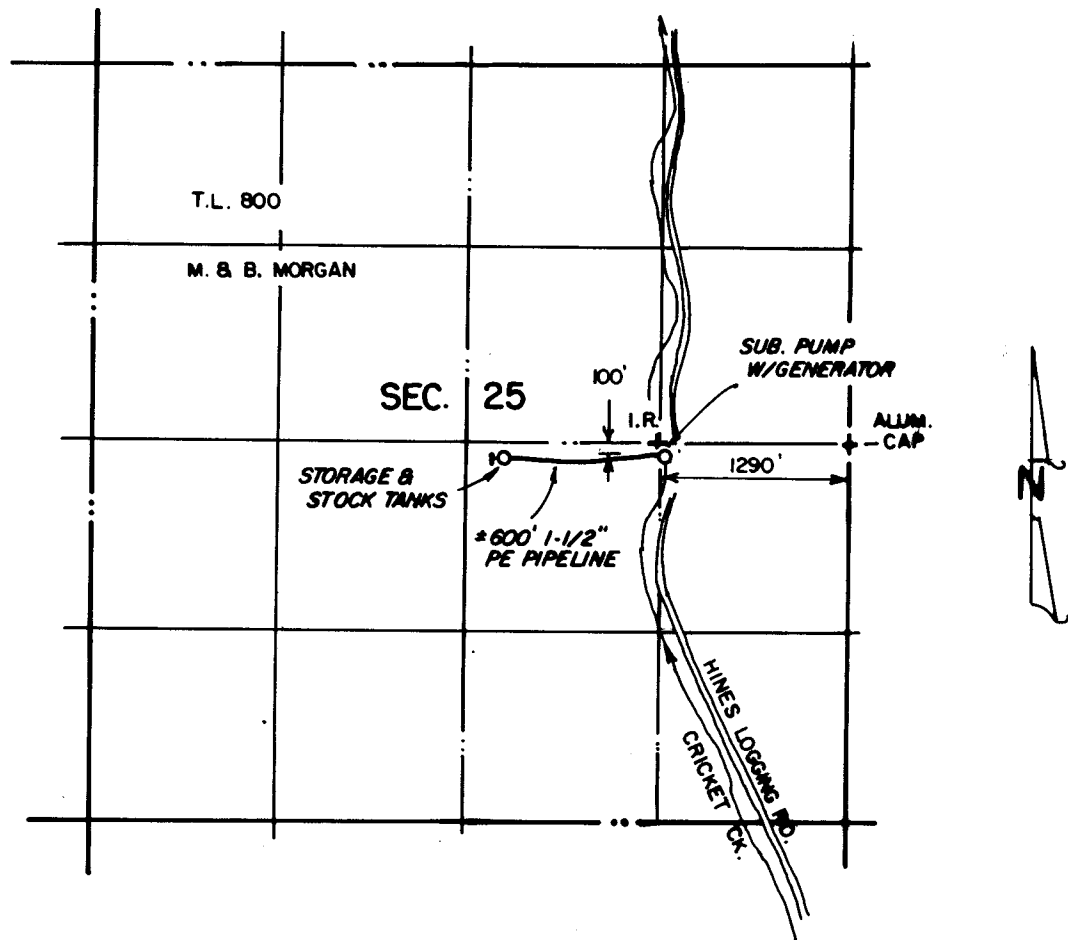

THE PURPOSE OF THIS MAP IS TO
IDENTIFY THE LOCATION OF THE
WATER RIGHT. IT IS NOT INTENDED
TO PROVIDE INFORMATION RELATIVE
TO THE LOCATION OF PROPERTY
OWNERSHIP.

	MIKE & BETTY MORGAN		BURNS, OREGON	
	FINAL PROOF MAP			
	UNDER APPLICATION NO. S-74152 & PERMIT NO. 51931			
	Scale: 1" = 1320'	Date: AUG. 27, 1997	Job: 1012	
	Dwn: - Dm: CORK Ckd: -	M. A. PALMER & SONS, INC. ENGINEERING & SURVEYING 224 N. Adler - Box 91 Burns, Oregon 97719		Sht. No. 1 of 1