


T. 36 S., R. 12 E., W.M.

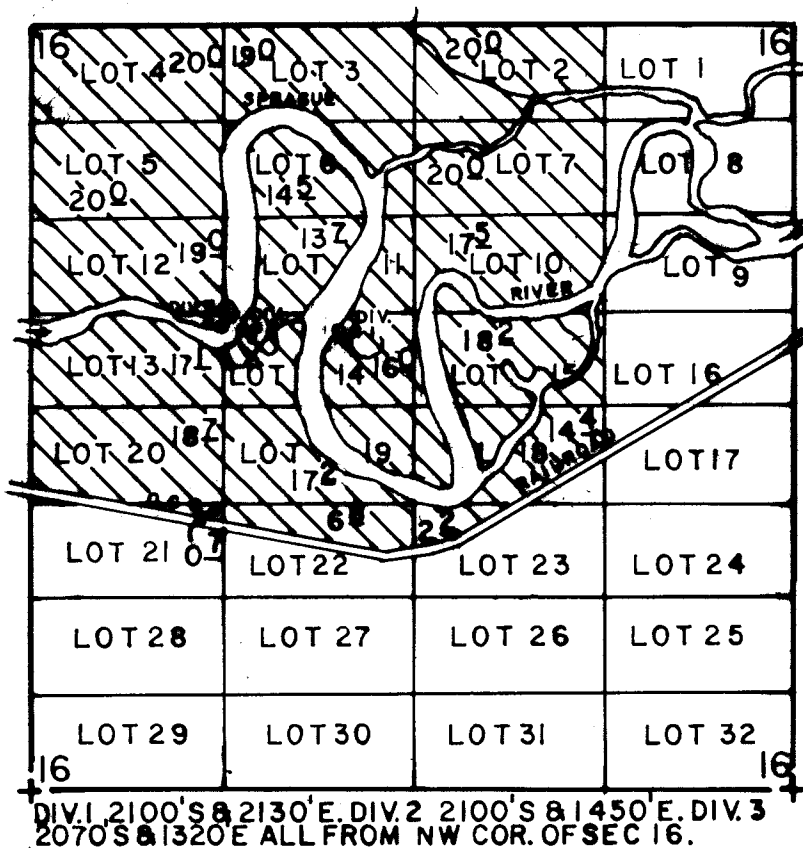

SCALE: 1" = 1320'

FINAL PROOF SURVEY

UNDER

Application No. 59551 Permit No. 44824
IN NAME OF

TERRY LEE HAGER AND DESSA LEA HAGER

Surveyed JUNE 19, 20, 1991, by B.W. BISHOP

January 10, 2003 by D. Sparks