


T. 36 S., R. 12 E., W.M.

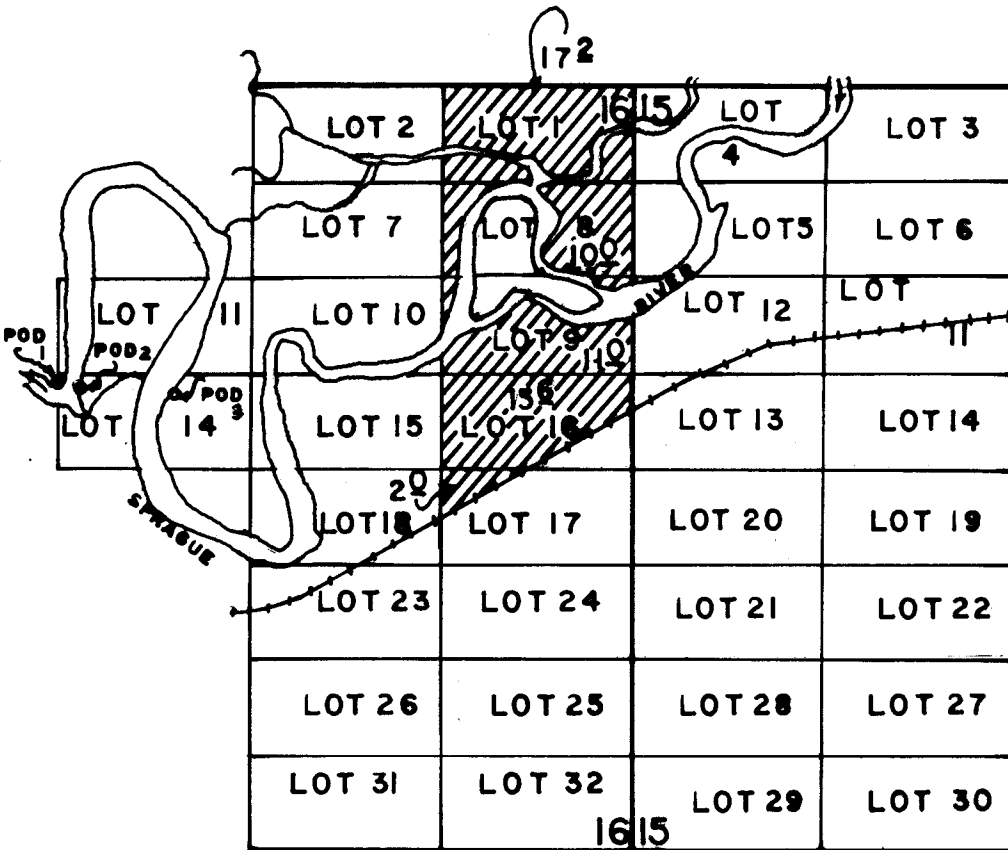

P.O.D.1. 2050' S & 3970' W FROM NE COR. OF SEC 16.
 P.O.D.2. 2100' S & 3820' W FROM NE COR. OF SEC 16.
 P.O.D.3. 2150' S & 3170' W FROM NE COR. OF SEC 16.
 ALL IN LOT 14. T.36 S., R.12 E., W.M. SEC 16.

SCALE: 1" = 1320'

FINAL PROOF SURVEY

UNDER

Application No. 65038 Permit No. 47533
 IN NAME OF

TERRY LEE HAGER AND DESSA LEA HAGER

Surveyed JUNE 19 & 20, 1991, by B.W.BISHOP

January 10, 2003 D. Sparks