
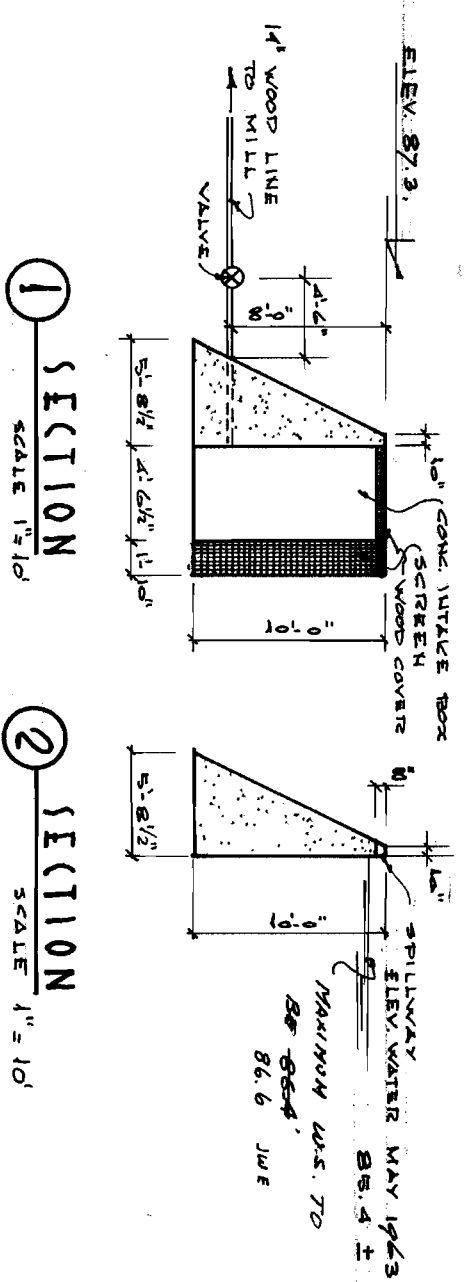
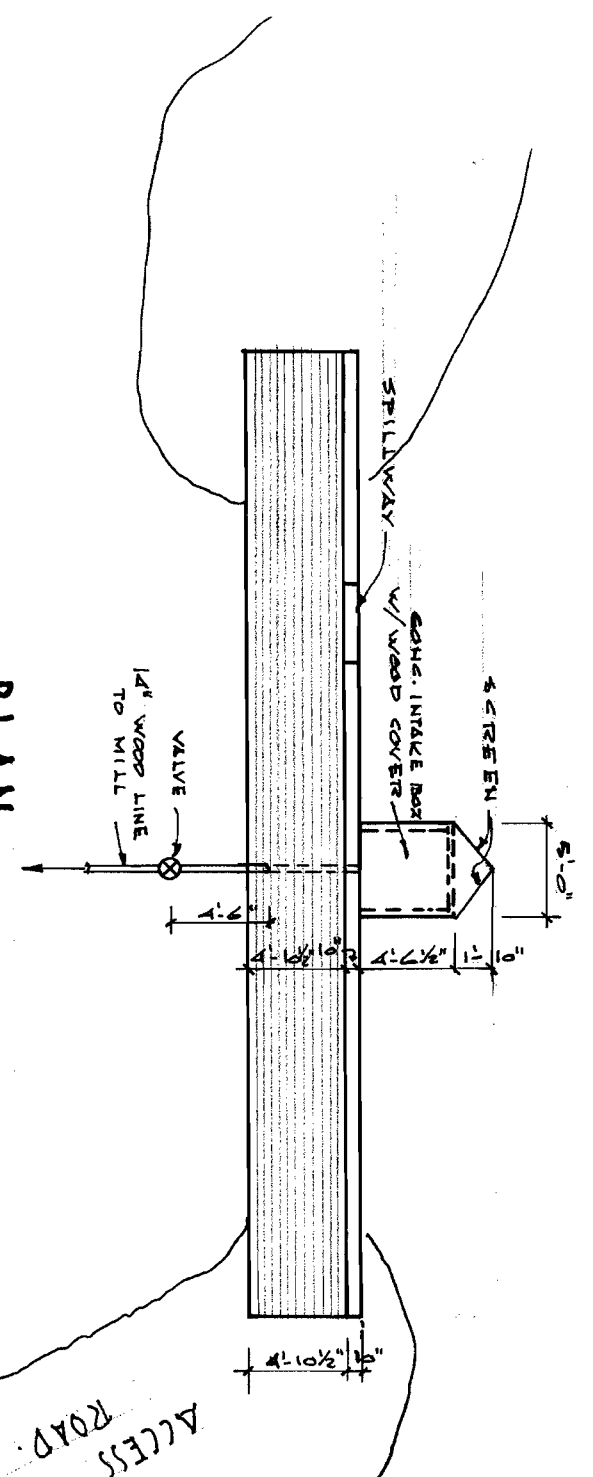


Application No. R-16015, 15921
 Permit No. R-3527, 29011


TAYLOR AVE.
 GRANT AVE.
 LINCOLN AVE.
 KELLY AVE.
 JACKSON AVE.
 REICHERT AVE.
 PENNSYLVANIA AVE.
 FARLEY AVE.

SCALE 1" = 500'

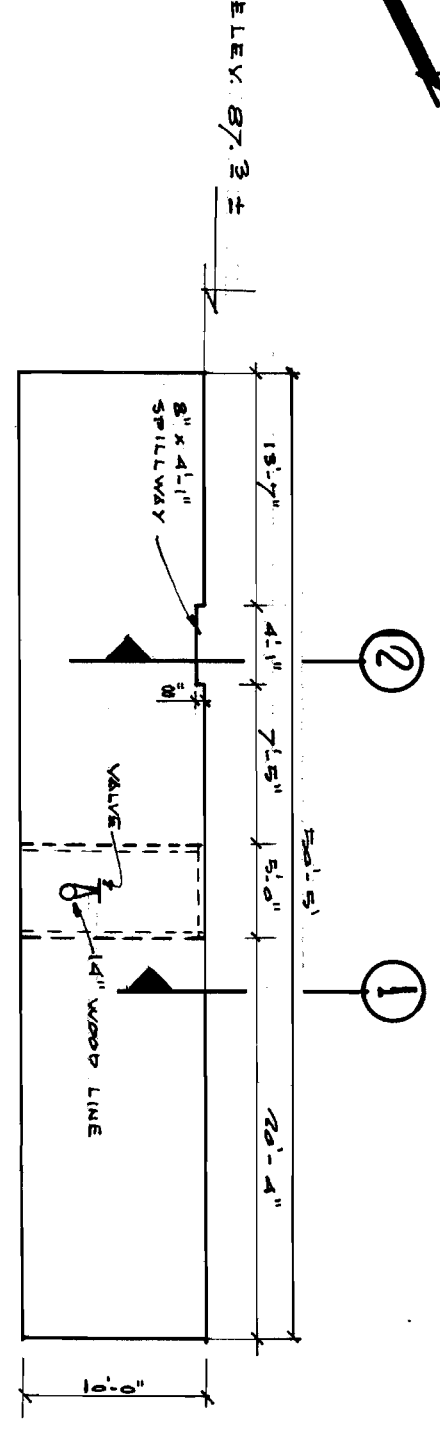

PLAN, ELEVATION & SECTIONS OF
 DIVERSION DAM

APPROVED Nov 5, 1963
Eric H. Erichsen
 STATE ENGINEER

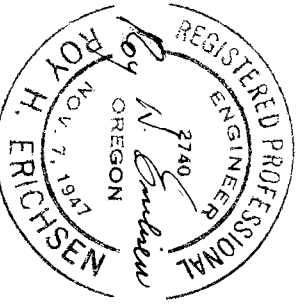

WATERRIGHT SURVEY


LOWER EMPIRE LAKE
 SECTION 17, TOWNSHIP 25 S. R 13 W/W.M.
 EMPIRE, COOS COUNTY, OREGON

DATE: 5-27-1963


SHEET 1 OF 2

Application No. R. 16015, 15921
 Permit No. R-3527, 29011

ACCESS ROAD
 DIVERSION DAM
 1/2" WOOD LINE
 TO MILL

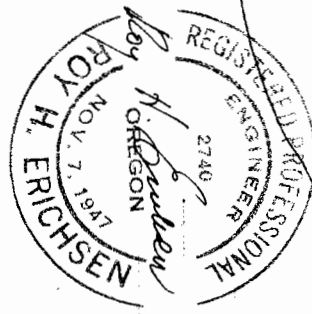

WATERRIGHT SURVEY
 LOWER EMPIRE LAKE
 SECTION 17, TOWNSHIP 25 S, R 15 W. WM.
 EMPIRE, COOS COUNTY, OREGON
 SCALE: 1" = 100'
 DATE: 5-27-1963
 SHEET 2 OF 2

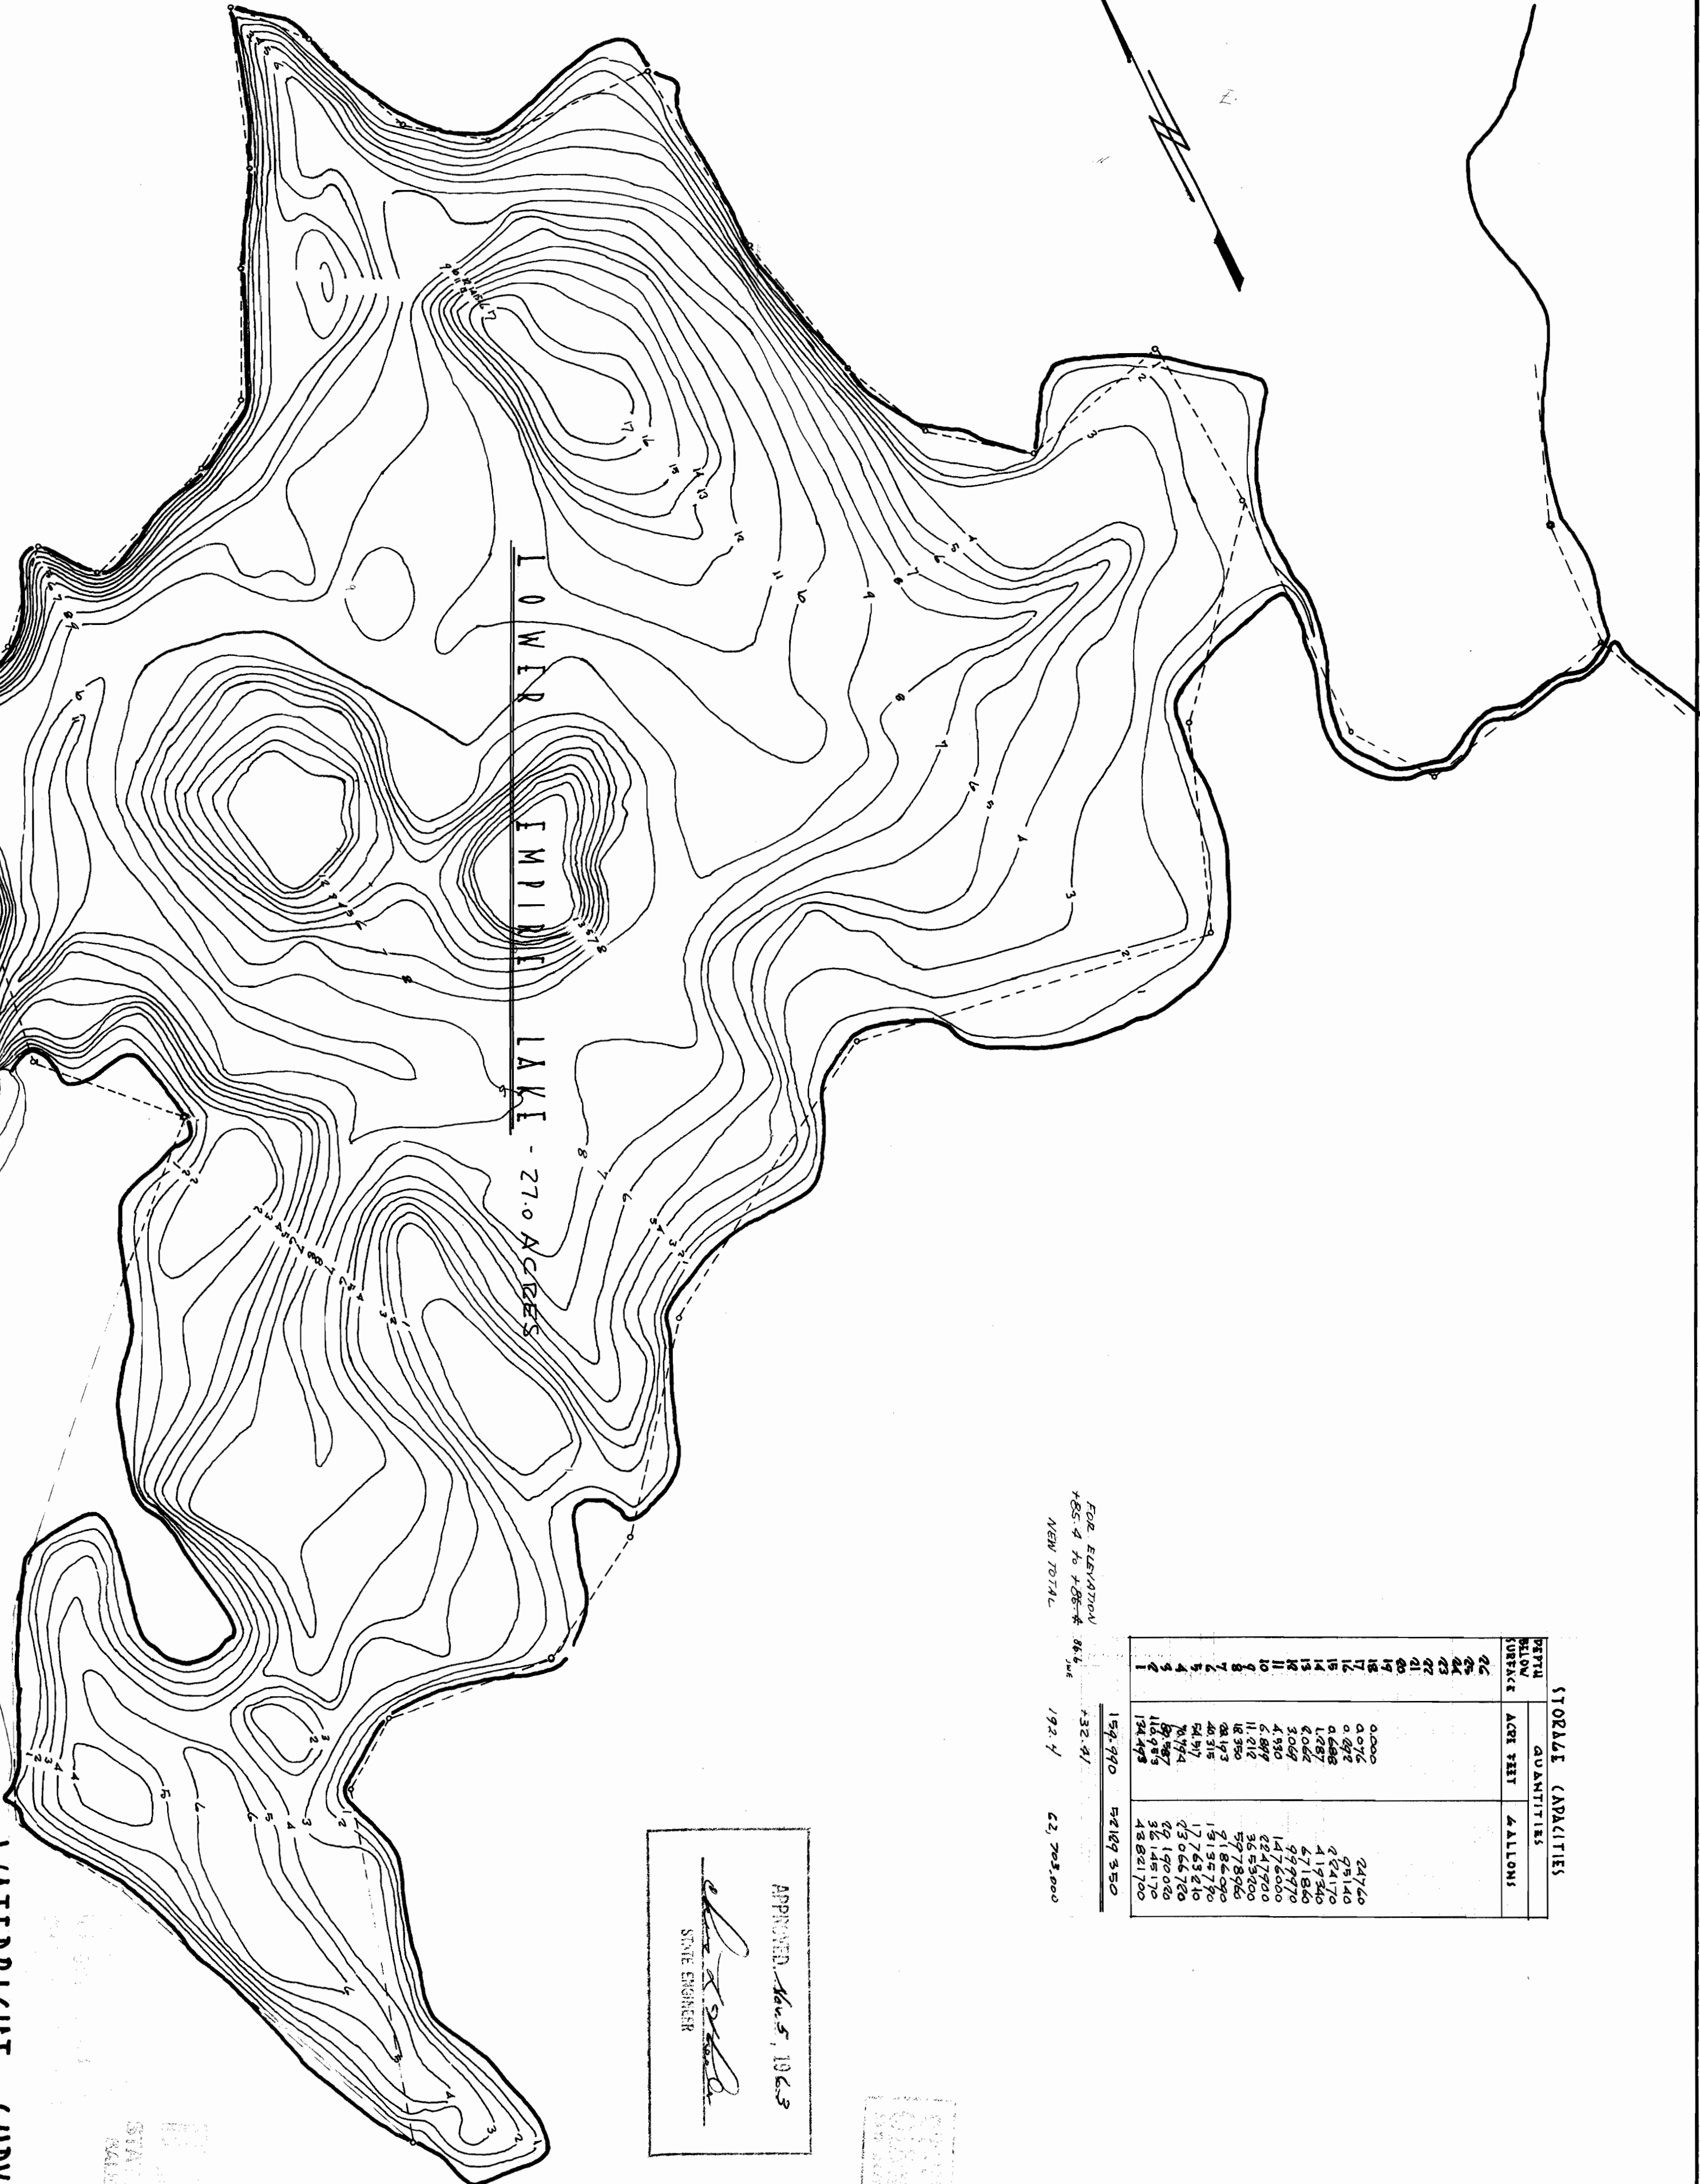

FOR ELEVATION
 +85.4 to +86.4
 NEW TOTAL 192.4

STORAGE CAPACITIES		
DEPTH BELOW SURFACE	ACRE FEET	GALLONS
NEW TOTAL	157.990	521.093.500

APPROVED: 164.5, 1963
R. H. Erichsen
 STATE ENGINEER

