


TOWNSHIP 3 NORTH, RANGE 26 & 27 EAST, W. M.

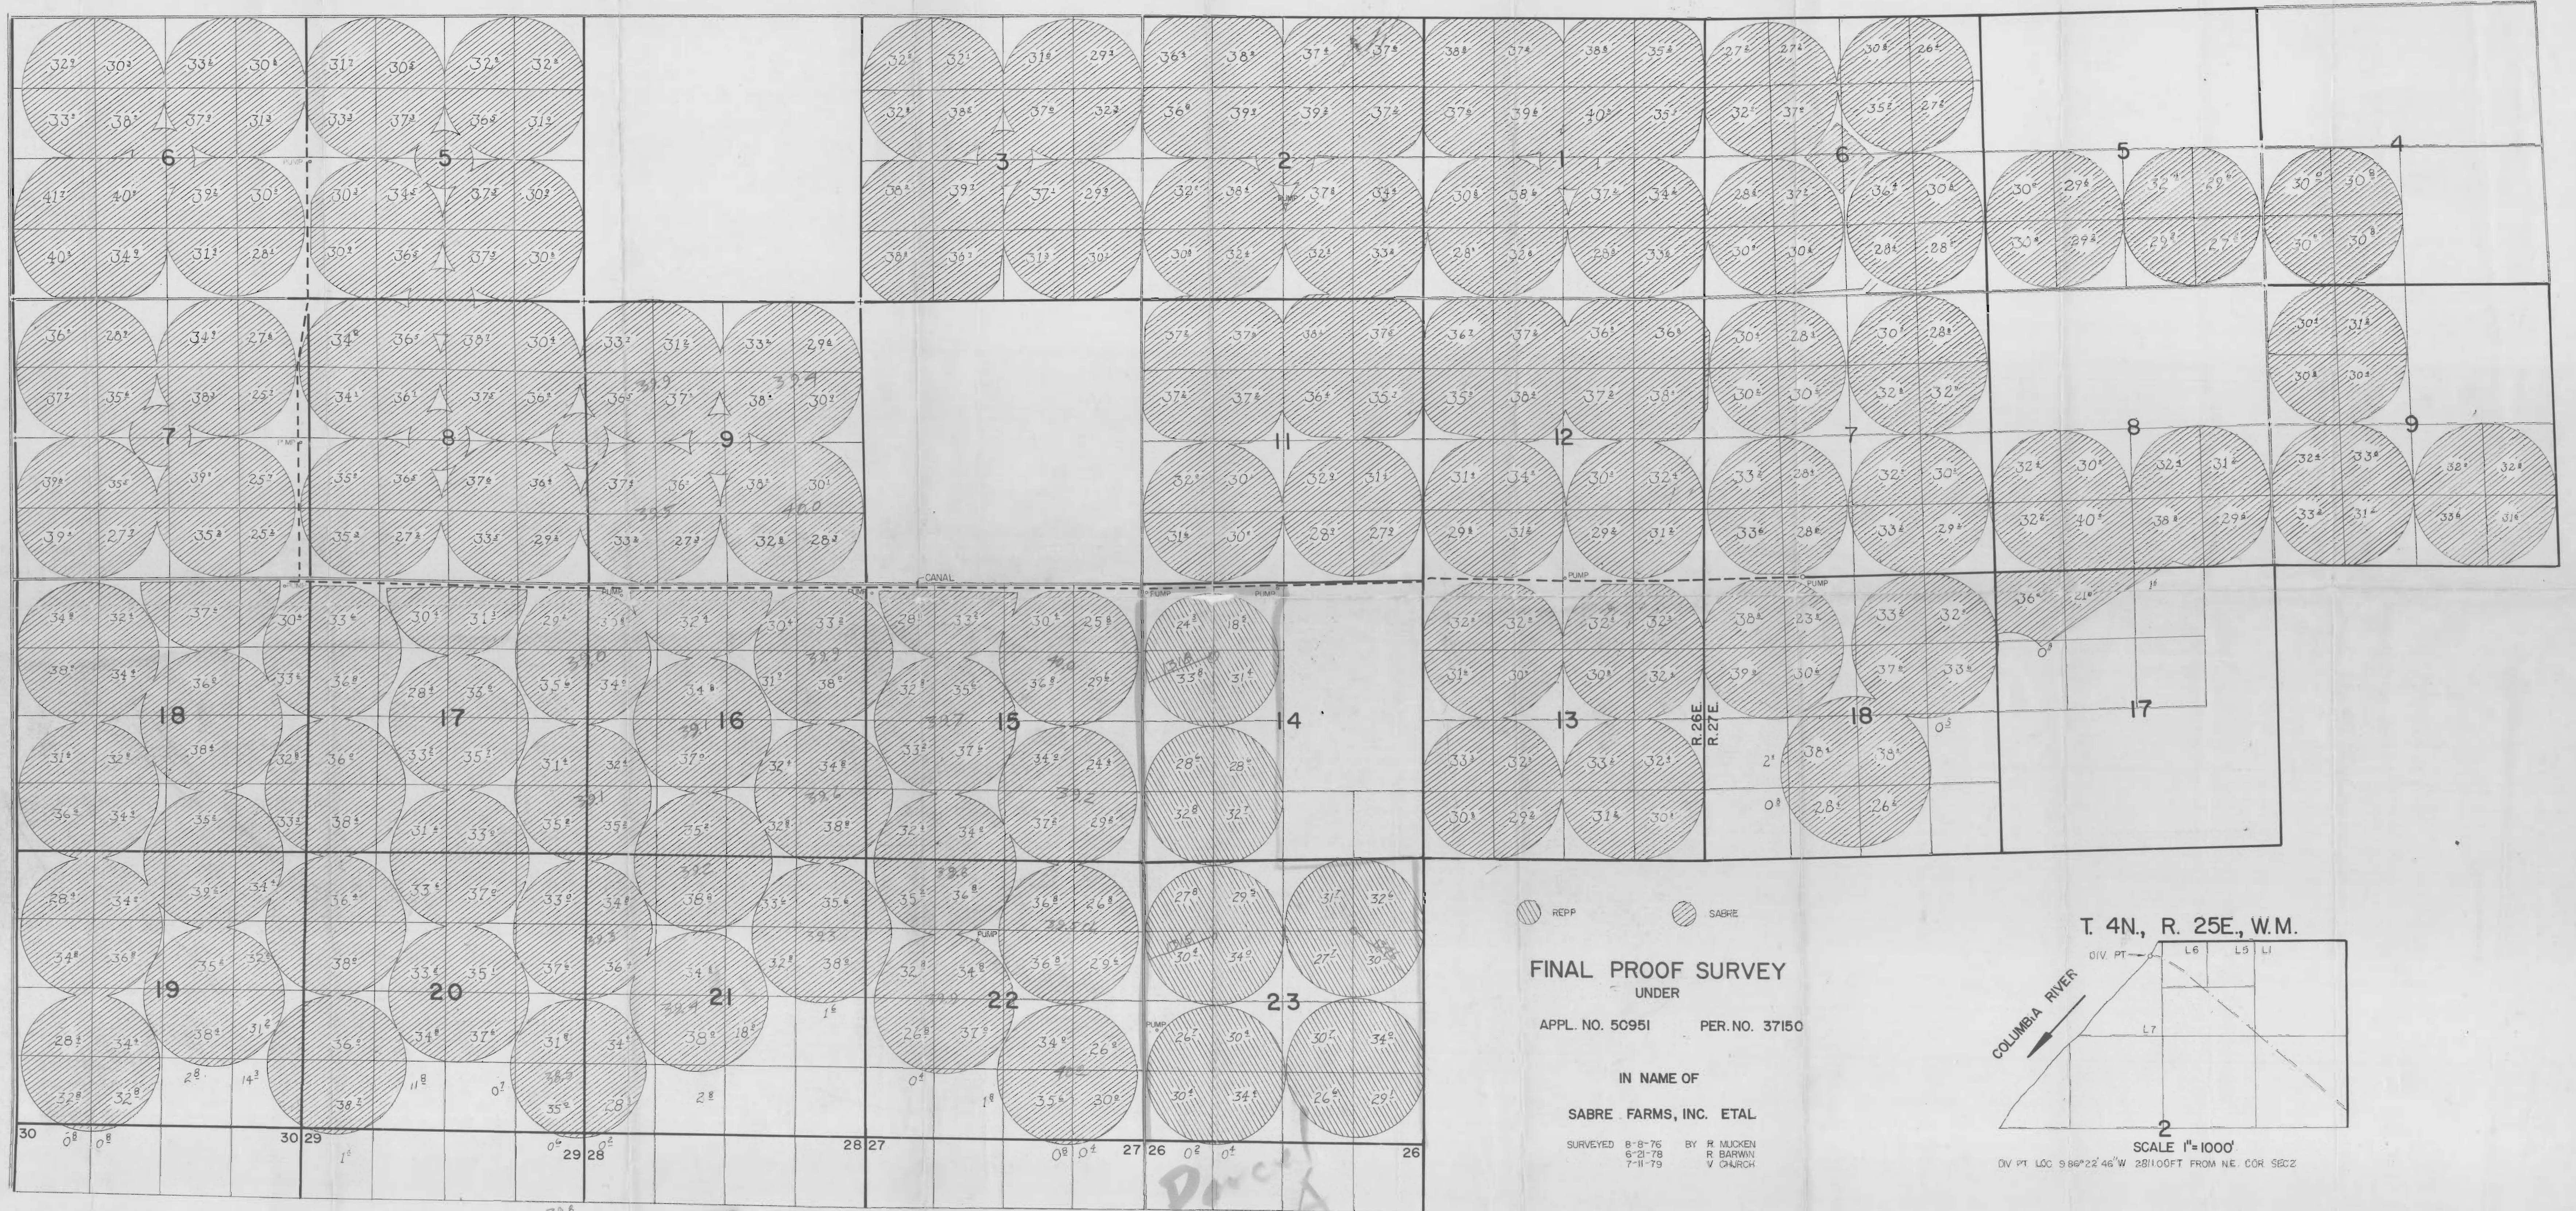

REPP SABRE

FINAL PROOF SURVEY
UNDER

APPL. NO. 50951 PER. NO. 37150

IN NAME OF

SABRE FARMS, INC. ETAL

SURVEYED 8-8-76 BY R. MUCKEN
6-21-78 R. BARWIN
7-11-79 V. CHURCH

