


Township 5 South Range 1 East, W.M.

Portions of Sections 25 & 26

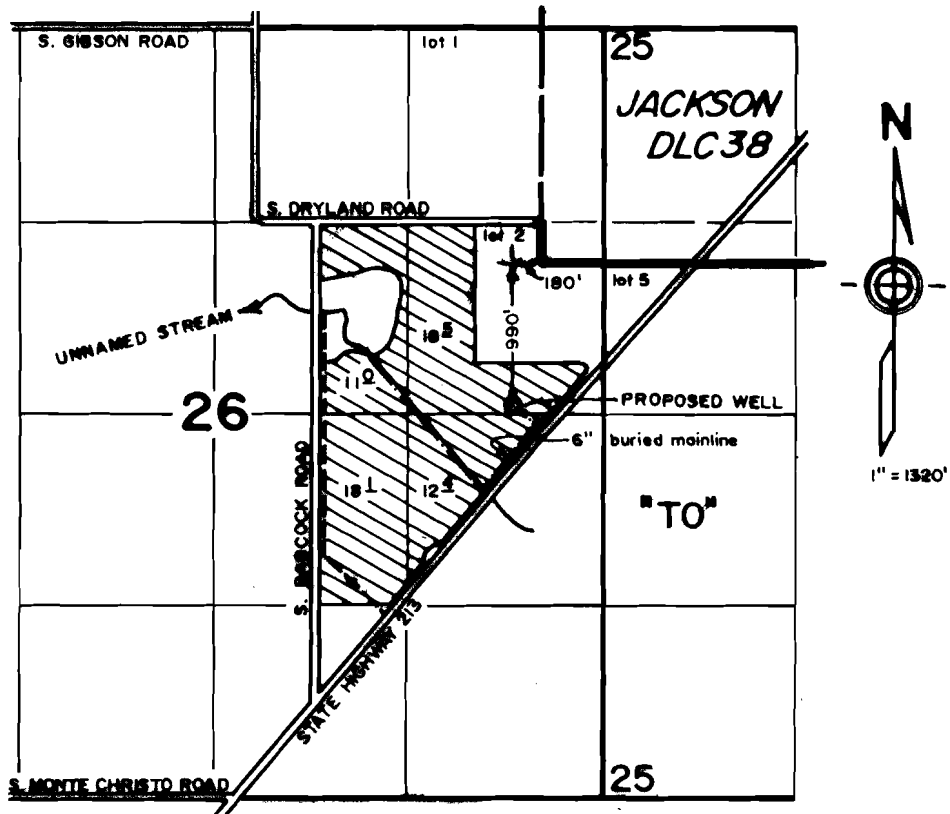

FINAL PROOF SURVEY
under

Transfer 6591
in name of


KRAEMER FARMS

September 21, 1993

RECEIVED

OCT 08 1993

WATER RESOURCES
DIVISION OREGON

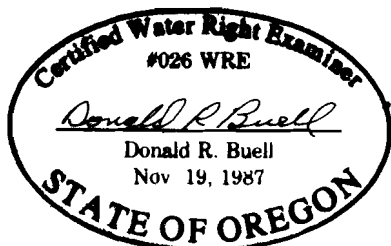

THIS MAP WAS PREPARED FOR THE PURPOSE OF IDENTIFYING THE LOCATION OF A WATER RIGHT ONLY AND IS NOT INTENDED TO PROVIDE LEGAL DIMENSIONS OR LOCATION OF PROPERTY OWNERSHIP LINES.