

Application R-84111
Permit R-12771


NE1/4 SEC. 3 T.28S. R.6W. W.M.
DOUGLAS COUNTY

RECEIVED

MAY 04 2001

WATER RESOURCES DEPT.
SALEM, OREGON

1"=200'

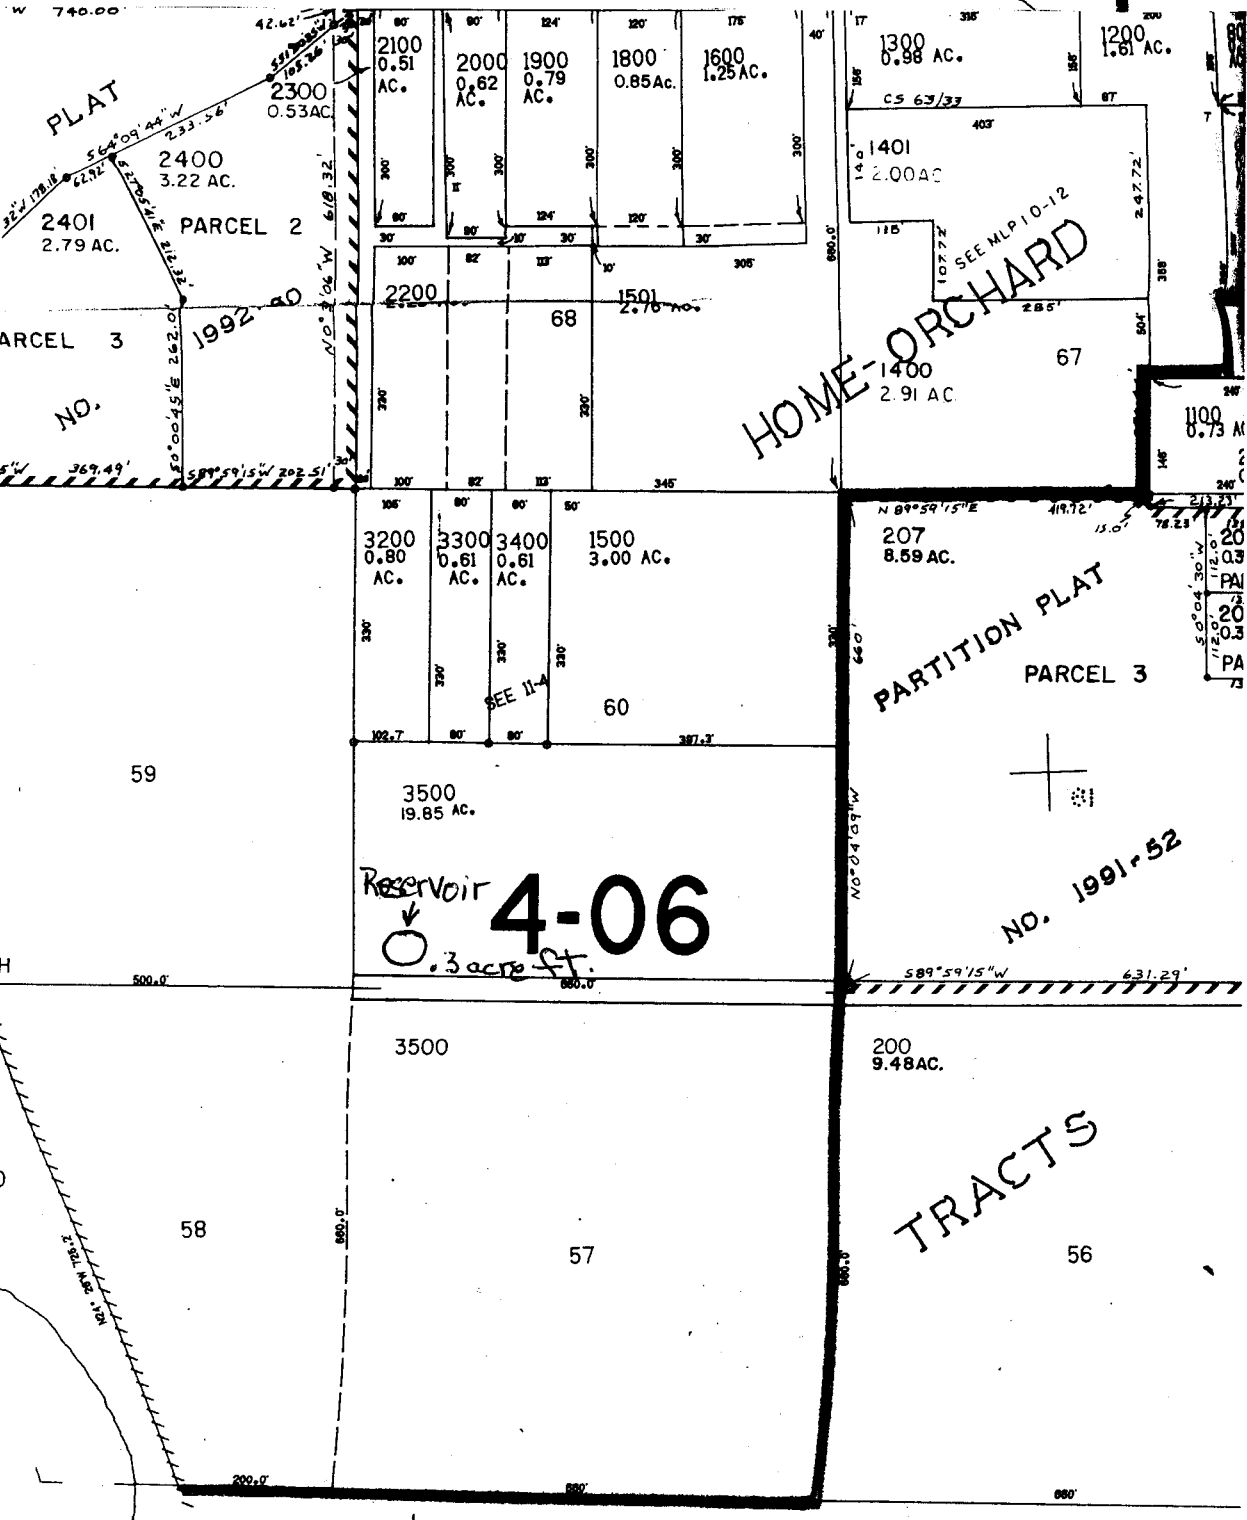

SEE MAP 28 6 3D

0.000