

RECEIVED

SECTION 13,  
T.1S., R.3E., W.M.

APR 8 1999 12 7

WATER RESOURCES DEPT.  
SALEM, OREGON 13 8

NORTH 1/4 CORNER

SE FOXGLOVE DR.

SE WOODLAND DR.

POWELL VALLEY RD.

THE DAM IS 1265 FEET SOUTH  
OF THE NORTH 1/4 CORNER

SE 262ND AVE.

CENTER  
SECTION

SE SALQUIST RD.

EAST 1/4  
CORNER


SCALE: 1"=400'

BASIS OF BEARINGS: 1964 MARX AND CHASE SURVEY

FINAL PROOF SURVEY

UNDER APPLICATION # R-81059 PERMIT # R-11969

IN THE NAME OF: CITY OF GRESHAM

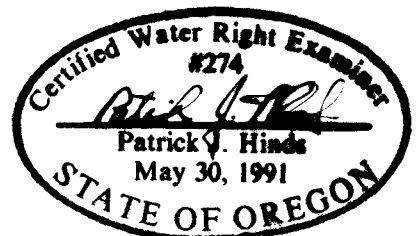

SURVEYED FEB. 19, 1999, BY PATRICK J. HINDS