

SEP 13 1999

RECEIVED


Application R-81205
Permit R-11994

1 Ac = 43,560 SQ FT.

EST. 10,000 SQ FT.

AVG.
DEPTH 3.5 FT.

POND -
10,000 S.F. = .23 Ac
X 3.5 FT DEEP
= .81 Ac. FT.

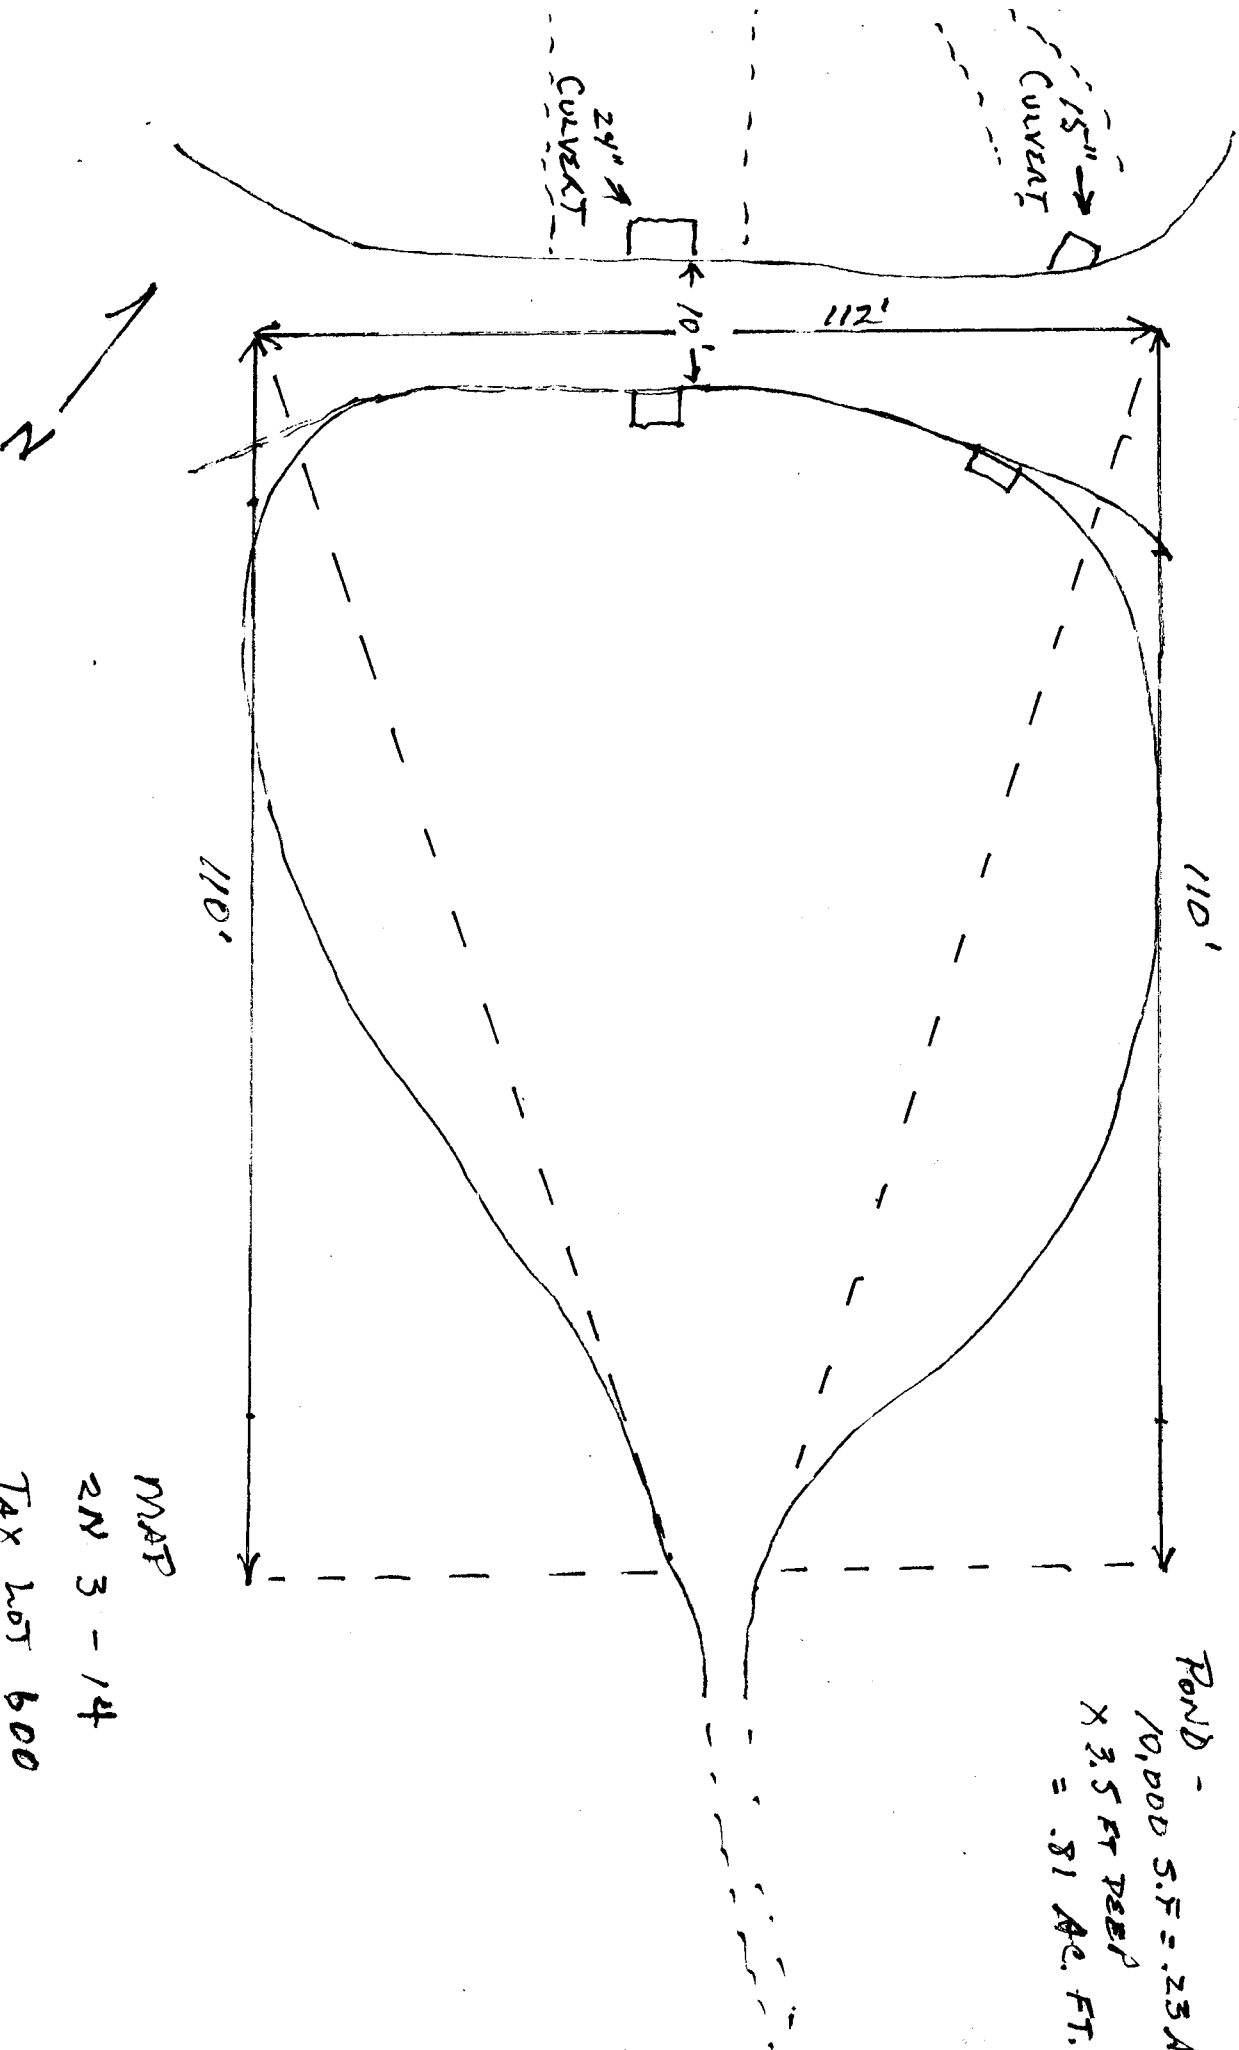

MAP

2N 3-14

TAX LOT 600