




**RECEIVE**

JUL 27 1998

WATER RESOURCES DE  
SALEM, OREGON

V. 6-244

SPECIAL NOTE: The only purpose of this drawing is to show the location of a pond situated on 9.19 ACRES at 15880 Airline Road, Town of Monmouth, County of POLK, Oregon 97338.61. Water is not diverted from the pond nor are there any facilities, pipelines, ditches, etc. in place for such diversion.

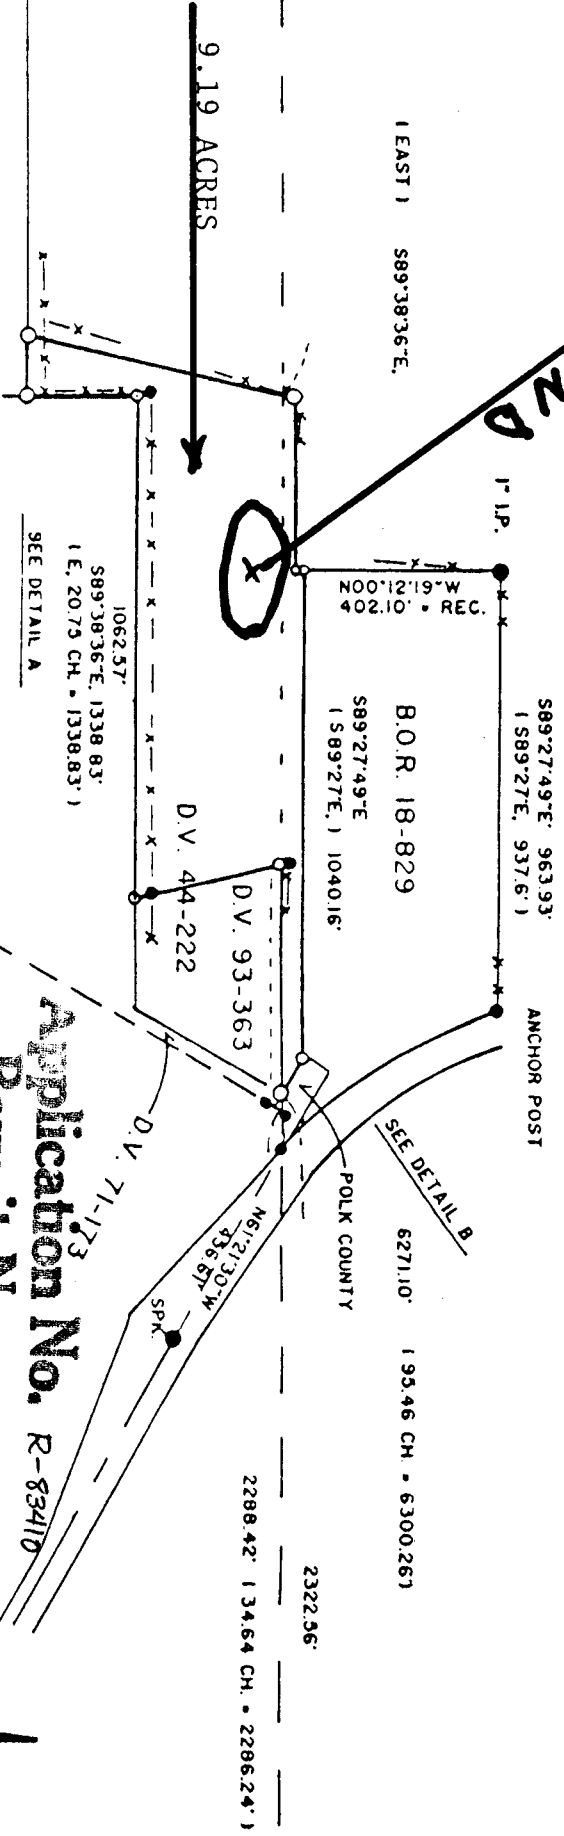

**Application No. R-83410**  
**Permit No. R-12421**

REGISTERED  
PROFESSIONAL  
LAND SURVEYOR  
*Ronald H. Schultson*  
ORIGON  
RONALD H. SCHULTSON  
11-03

SURVEY. PREPARED FOR AND AT THE REQUEST OF <b>HARVEY HOLT</b>		J & R NO. 87-11-09
LOCATION: JONATHAN LIGGETT, DLG • 53		SCALE: 1" = 400'
SW 1/4 SECTION 12 T. 9 S. R. 5 W. W.M. POLK COUNTY, OREGON		DATE: 12/1/87
P.O. BOX 418 DALLAS, OREGON 97338		X-X-X = Existing Fence
<b>J &amp; R SURVEYORS</b>		● = FOUND Monument as noted.
TELEPHONE: 623-4003		( ) = Record Distance & Bearing.
		○ = SET. 5/8"x30" REBAR Monument, With Aluminum CAP

