


# CLAIM OF BENEFICIAL USE MAP

UNDER APPLICATION R-81939; PERMIT R-12379

NE1/4 SE1/4 SEC 25 T 39S R 43E V.M.

U.S.G.S. QUAD - GRASSHOPPER FLAT SOUTH, OREG. - 7 1/2'

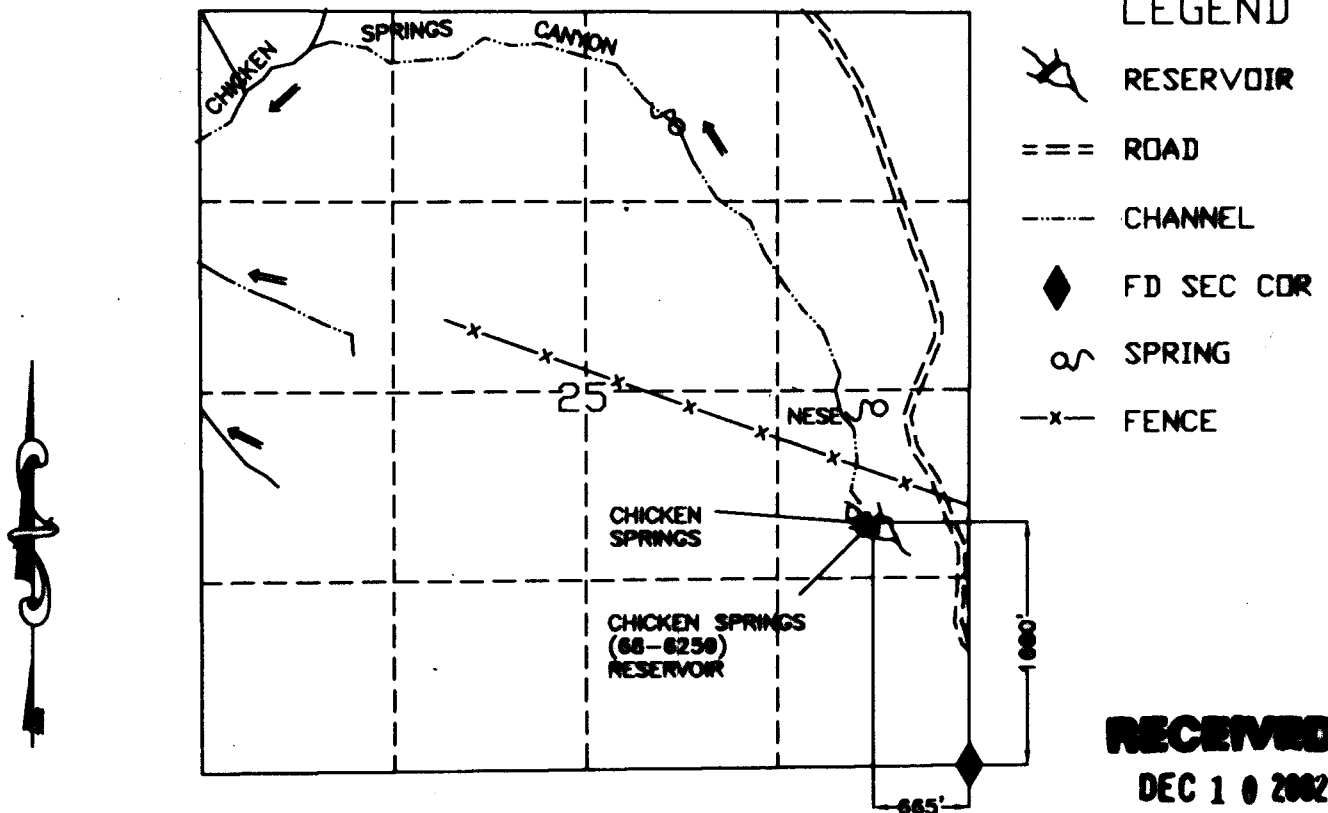

**RECEIVED**  
DEC 10 2002

WATER RESOURCES DEPT.  
SALEM, OREGON

## CHICKEN SPRINGS (68-6259) RESERVOIR



I, Thomas Terry, ADM Operations/Field Services agree to the findings of the CMRE and do submit this site report and map as my Claim of Beneficial Use of the water as provided under the terms and conditions of my Permit R-12374

*Thomas Terry*



THIS MAP IS FOR THE PURPOSE OF LOCATING A WATER RIGHT AND IS NOT INTENDED TO PROVIDE LEGAL DIMENSIONS FOR LOCATION OF PROPERTY BOUNDARIES.

ACAD2000/LBO  
BYG FLECHICKENSBN

|   |                 |
|---|-----------------|
| UNITED STATES DEPARTMENT OF THE INTERIOR<br>BUREAU OF LAND MANAGEMENT<br>DIVISION OF OPERATIONS VALE DISTRICT |                 |
| CHICKEN SPRINGS<br>(68-6259) RESERVOIR                                                                        |                 |
| DRAWN BY: <i>Thomas R. Pate</i>                                                                               |                 |
| SURVEYED: <i>Thomas R. Pate</i>                                                                               |                 |
| APPROVED: <i>Thomas R. Pate</i>                                                                               |                 |
| DRAWN: CG   | SCALE: 1"=1320' |
| DATE: 11/01/01                                                                                                | SHEET 1 OF 1    |
| DRAWING NO. OR-03-9172.45-00                                                                                  |                 |