


CLAIM OF BENEFICIAL USE MAP

UNDER APPLICATION R-82528; PERMIT R-12434

NW1/4 NE1/4 SEC 19 T 39S R 40E W.M.

U.S.G.S. QUAD - DOOLITTLE CREEK, OREG. - 7 1/2'

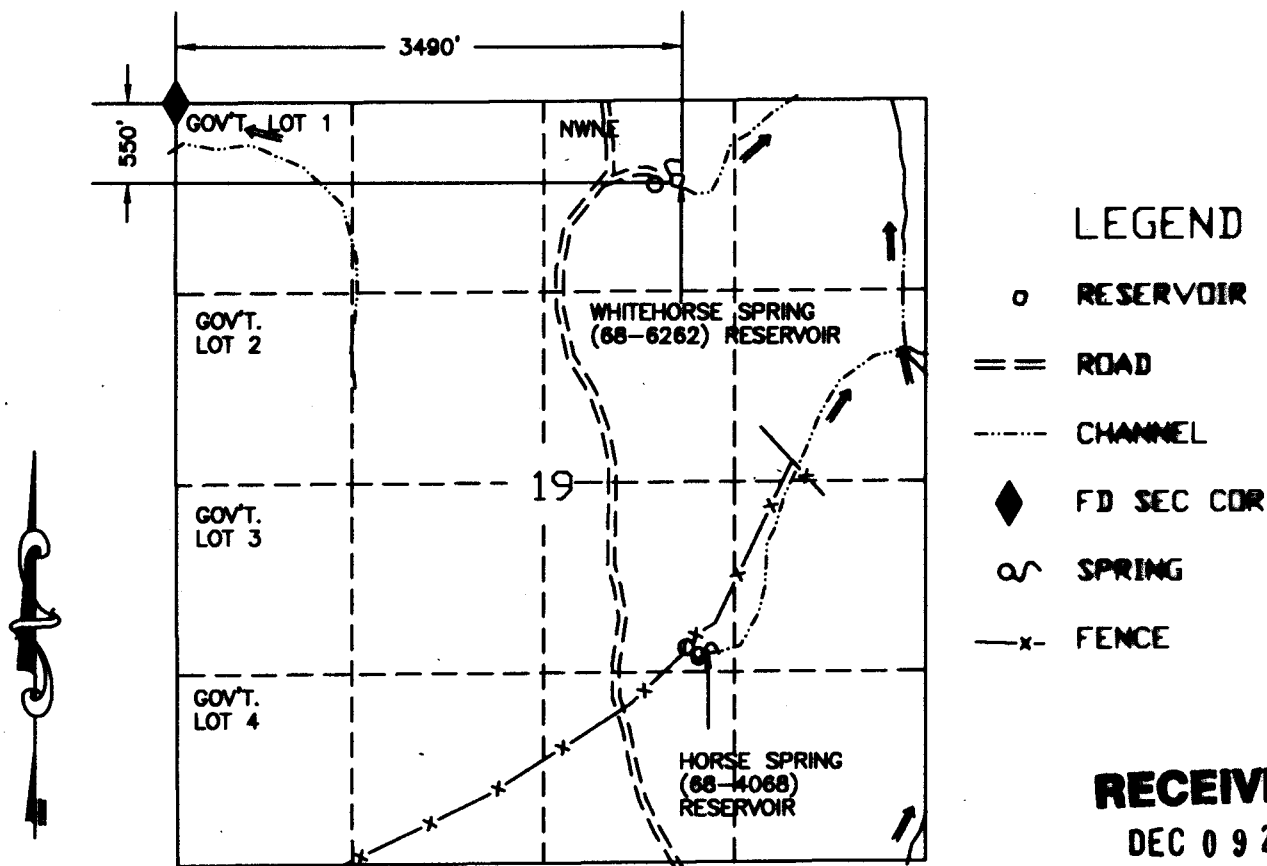

LEGEND


- RESERVOIR
- == ROAD
- CHANNEL
- ◆ FD SEC COR
- ⊞ SPRING
- x- FENCE

RECEIVED

DEC 09 2002

WATER RESOURCES DEPT.
SALEM, OREGON

WHITEHORSE SPRING (68-6262) RESERVOIR

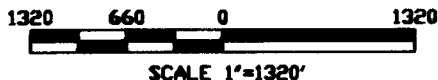

I, Thomas Terry ADM Operations/Field Services agree to the findings of the CWRE and do submit this site report and map as my Claim of Beneficial Use of the water as provided under the terms and conditions of my Permit R-12434.

Thomas Terry



THIS MAP IS FOR THE PURPOSE OF LOCATING A WATER RIGHT AND IS NOT INTENDED TO PROVIDE LEGAL DIMENSIONS FOR LOCATION OF PROPERTY BOUNDARIES.

ACAB2000
BVG FILE WHITEHSPBEN

UNITED STATES DEPARTMENT OF THE INTERIOR BUREAU OF LAND MANAGEMENT DIVISION OF OPERATIONS VALE DISTRICT	
WHITEHORSE SPRING (68-6262) RESERVOIR	
DRAWN BY: <i>Thomas Terry</i>	
SURVEYED: <i>Thomas Terry</i>	
APPROVED: <i>Thomas Terry</i>	
DRAWN: CG	SCALE: 1"=1320'
DATE: 11/08/01	SHEET 1 OF 1
DRAWING NO. OR-03-9172.45-1112	