


CLAIM OF BENEFICIAL USE MAP


UNDER APPLICATION R-83412; PERMIT R-12364

NE1/4SW1/4 SEC 34 T 28S R 43E W.M.

U.S.G.S. QUAD - JORDAN CRATERS SOUTH, OREG. - 7 1/2'

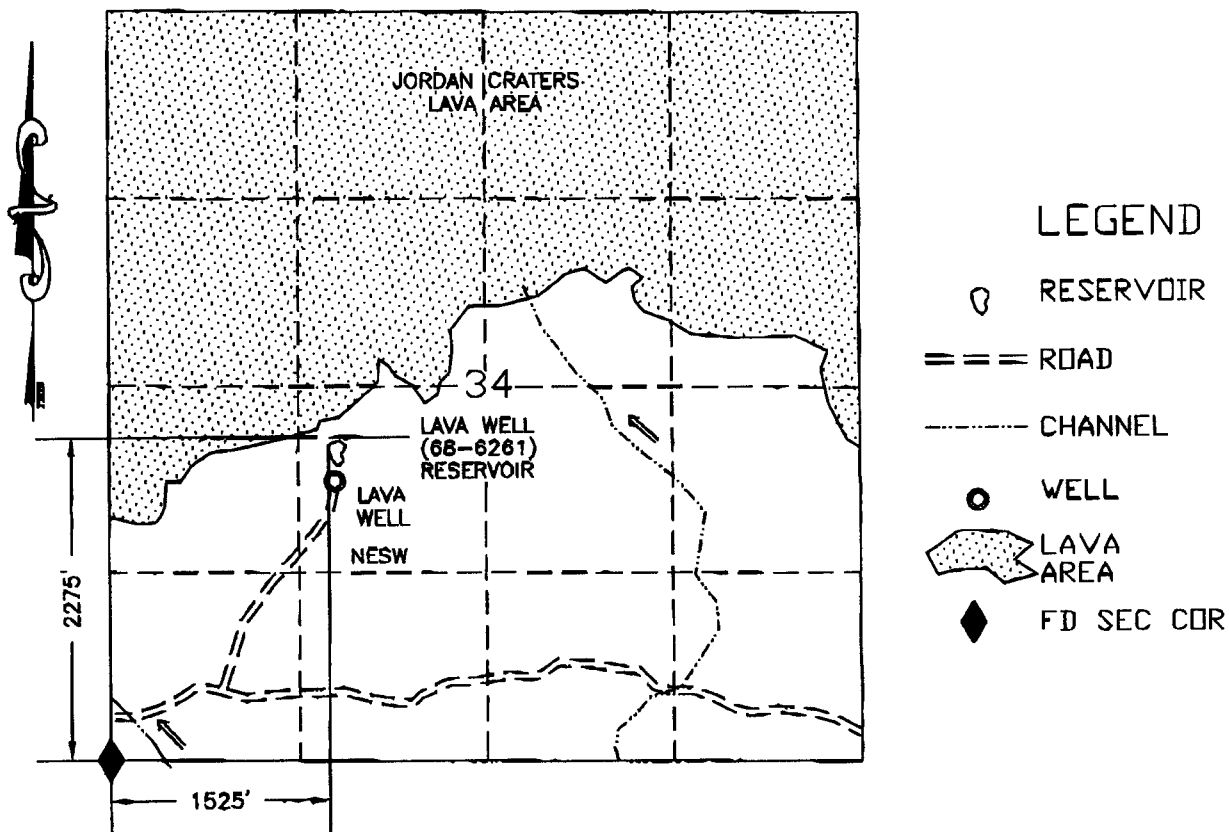

LAVA WELL (68-6261) RESERVOIR

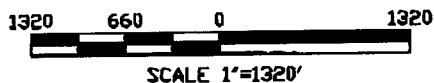

I, Thomas D. Terry, ADM Division of Field Services agree to the findings of the CWRE and do submit this site report and map as my Claim of Beneficial Use of the water as provided under the terms and conditions of my Permit R-12364.

THIS MAP IS FOR THE PURPOSE OF LOCATING A WATER RIGHT AND IS NOT INTENDED TO PROVIDE LEGAL DIMENSIONS FOR LOCATION OF PROPERTY BOUNDARIES.



UNITED STATES DEPARTMENT OF THE INTERIOR
BUREAU OF LAND MANAGEMENT
DIVISION OF OPERATIONS VALE DISTRICT

LAVA WELL (68-6261) RESERVOIR

DRAWN BY: _____

SURVEYED: _____

APPROVED: _____

ADM OPERATIONS AND FIELD SERVICES

DRAWN: CG SCALE: 1"=1320'

DATE: 11/01/01 SHEET 1 OF 1

DRAWING NO. OR-03-9172.45-989

ACAD2000
DWG FILE: AVAVELL-BEN