


CLAIM OF BENEFICIAL USE MAP

UNDER APPLICATION NE1/4; PERMIT R-12367

NE1/4 NW1/4 SEC 8 T 39S R 44E W.M.

U.S.G.S. QUAD - GRASSHOPPER FLAT SOUTH, OREG. - 7 1/2'

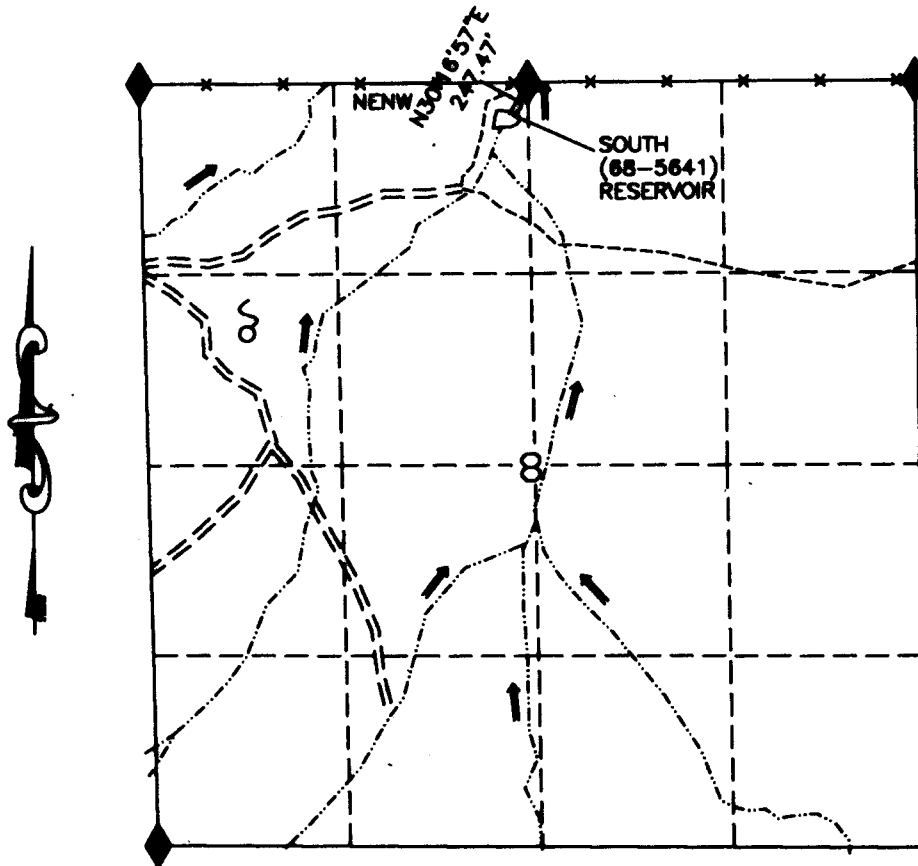

LEGEND


- D RESERVOIR
- == ROAD
- - - CHANNEL
- ◆ FD SEC COR
- ⊙ SPRING
- - - TRAIL
- x - FENCE

RECEIVED

DEC 09 2002

SOUTH (68-5641) RESERVOIR

WATER RESOURCES DEPT.
SALEM, OREGON

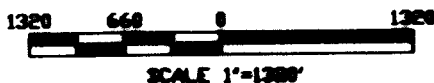

I, Thomas Terry ADM Operations/Field Services agree to the findings of the CURE and do submit this site report and map as my Claim of Beneficial Use of the water as provided under the terms and conditions of my Permit R-12367

Thomas Terry



THIS MAP IS FOR THE PURPOSE OF LOCATING A WATER RIGHT AND IS NOT INTENDED TO PROVIDE LEGAL DIMENSIONS FOR LOCATION OF PROPERTY BOUNDARIES.

ACAS0000
DWG FILE: SOUTH01EN

UNITED STATES DEPARTMENT OF THE INTERIOR BUREAU OF LAND MANAGEMENT DIVISION OF OPERATIONS VALE DISTRICT	
SOUTH (68-5641) RESERVOIR	
DRAWN BY: <i>Thomas R. Reed</i>	
SURVEYED: <i>Thomas R. Reed</i>	
APPROVED: <i>Thomas R. Reed</i>	
DRAWN: CG	SCALE: 1"=1320'
DATE: 11/08/01	SHEET 1 OF 1
DRAWING NO. OR-03-9172.45-1111	