


CLAIM OF BENEFICIAL USE MAP

UNDER APPLICATION R-82516; PERMIT R-12376

SE1/4 SE1/4 SEC 7 T 13S R 45E W.M.

U.S.G.S. QUAD - OLDS FERRY NW, IDAHO-OREG. - 7 1/2'

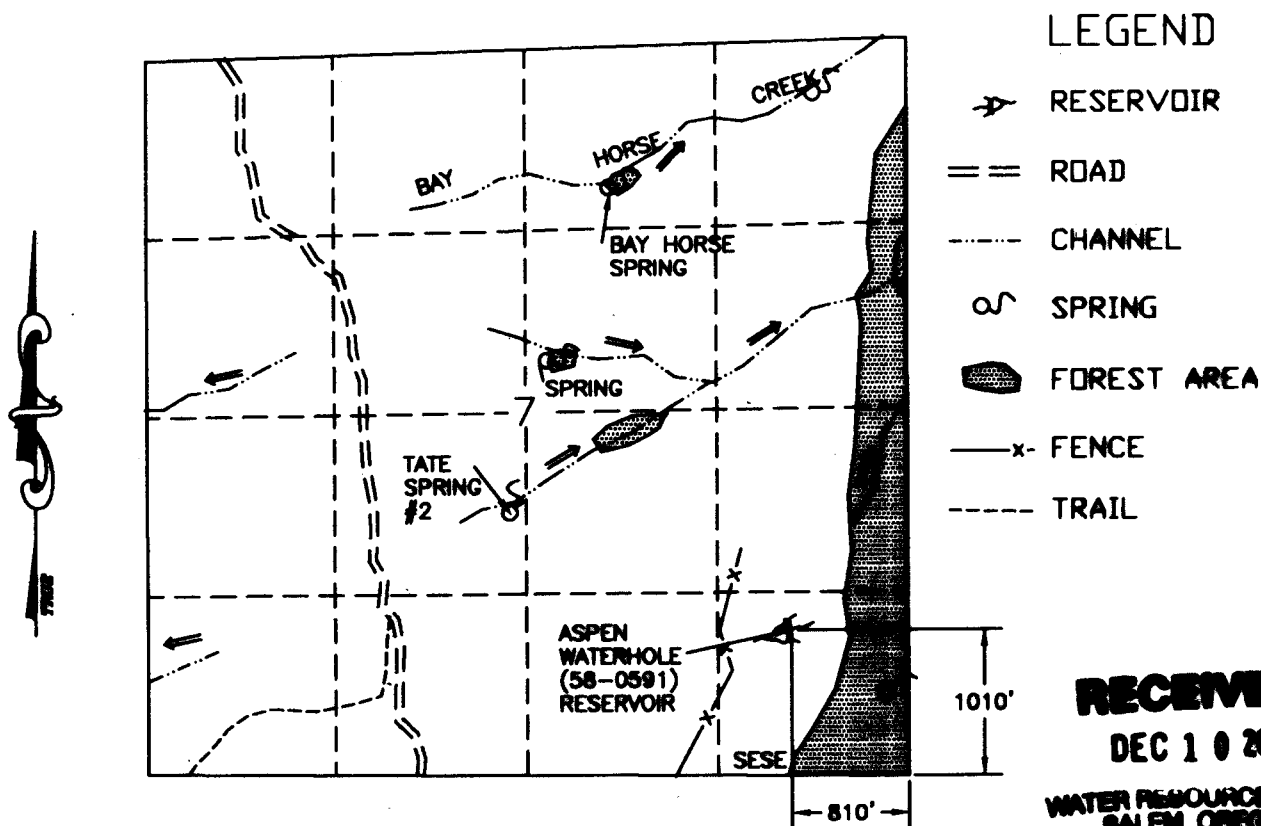

RECEIVED
DEC 10 2002
WATER RESOURCES DEPT
SALEM, OREGON

ASPEN WATERHOLE (58-0591) RESERVOIR

1320 660 0 1320
SCALE 1"=1320'

I, Thomas Terry ADM Operations/Field Services agree to the findings of the CWRE and do submit this site report and map as my Claim of Beneficial Use of the water as provided under the terms and conditions of my Permit R-12376

Thomas Terry



THIS MAP IS FOR THE PURPOSE OF LOCATING A WATER RIGHT AND IS NOT INTENDED TO PROVIDE LEGAL DIMENSIONS FOR LOCATION OF PROPERTY BOUNDARIES.

ACAD3000/L10
BVG FILES/ENVHBN

UNITED STATES DEPARTMENT OF THE INTERIOR BUREAU OF LAND MANAGEMENT DIVISION OF OPERATIONS VALE DISTRICT	
ASPEN WATERHOLE (58-0591) RESERVOIR	
DRAWN BY: <i>Thomas R. Terry</i>	
SURVEYED: <i>Thomas R. Terry</i>	
APPROVED: <i>Thomas R. Terry</i>	
DRAWN: CG	SCALE: 1"=1320'
DATE: 11/01/01	SHEET 1 OF 1
DRAWING NO. DR-03-9172.45-1100	