T18, R6W, Sec. 2

SCALE 1" = 800'

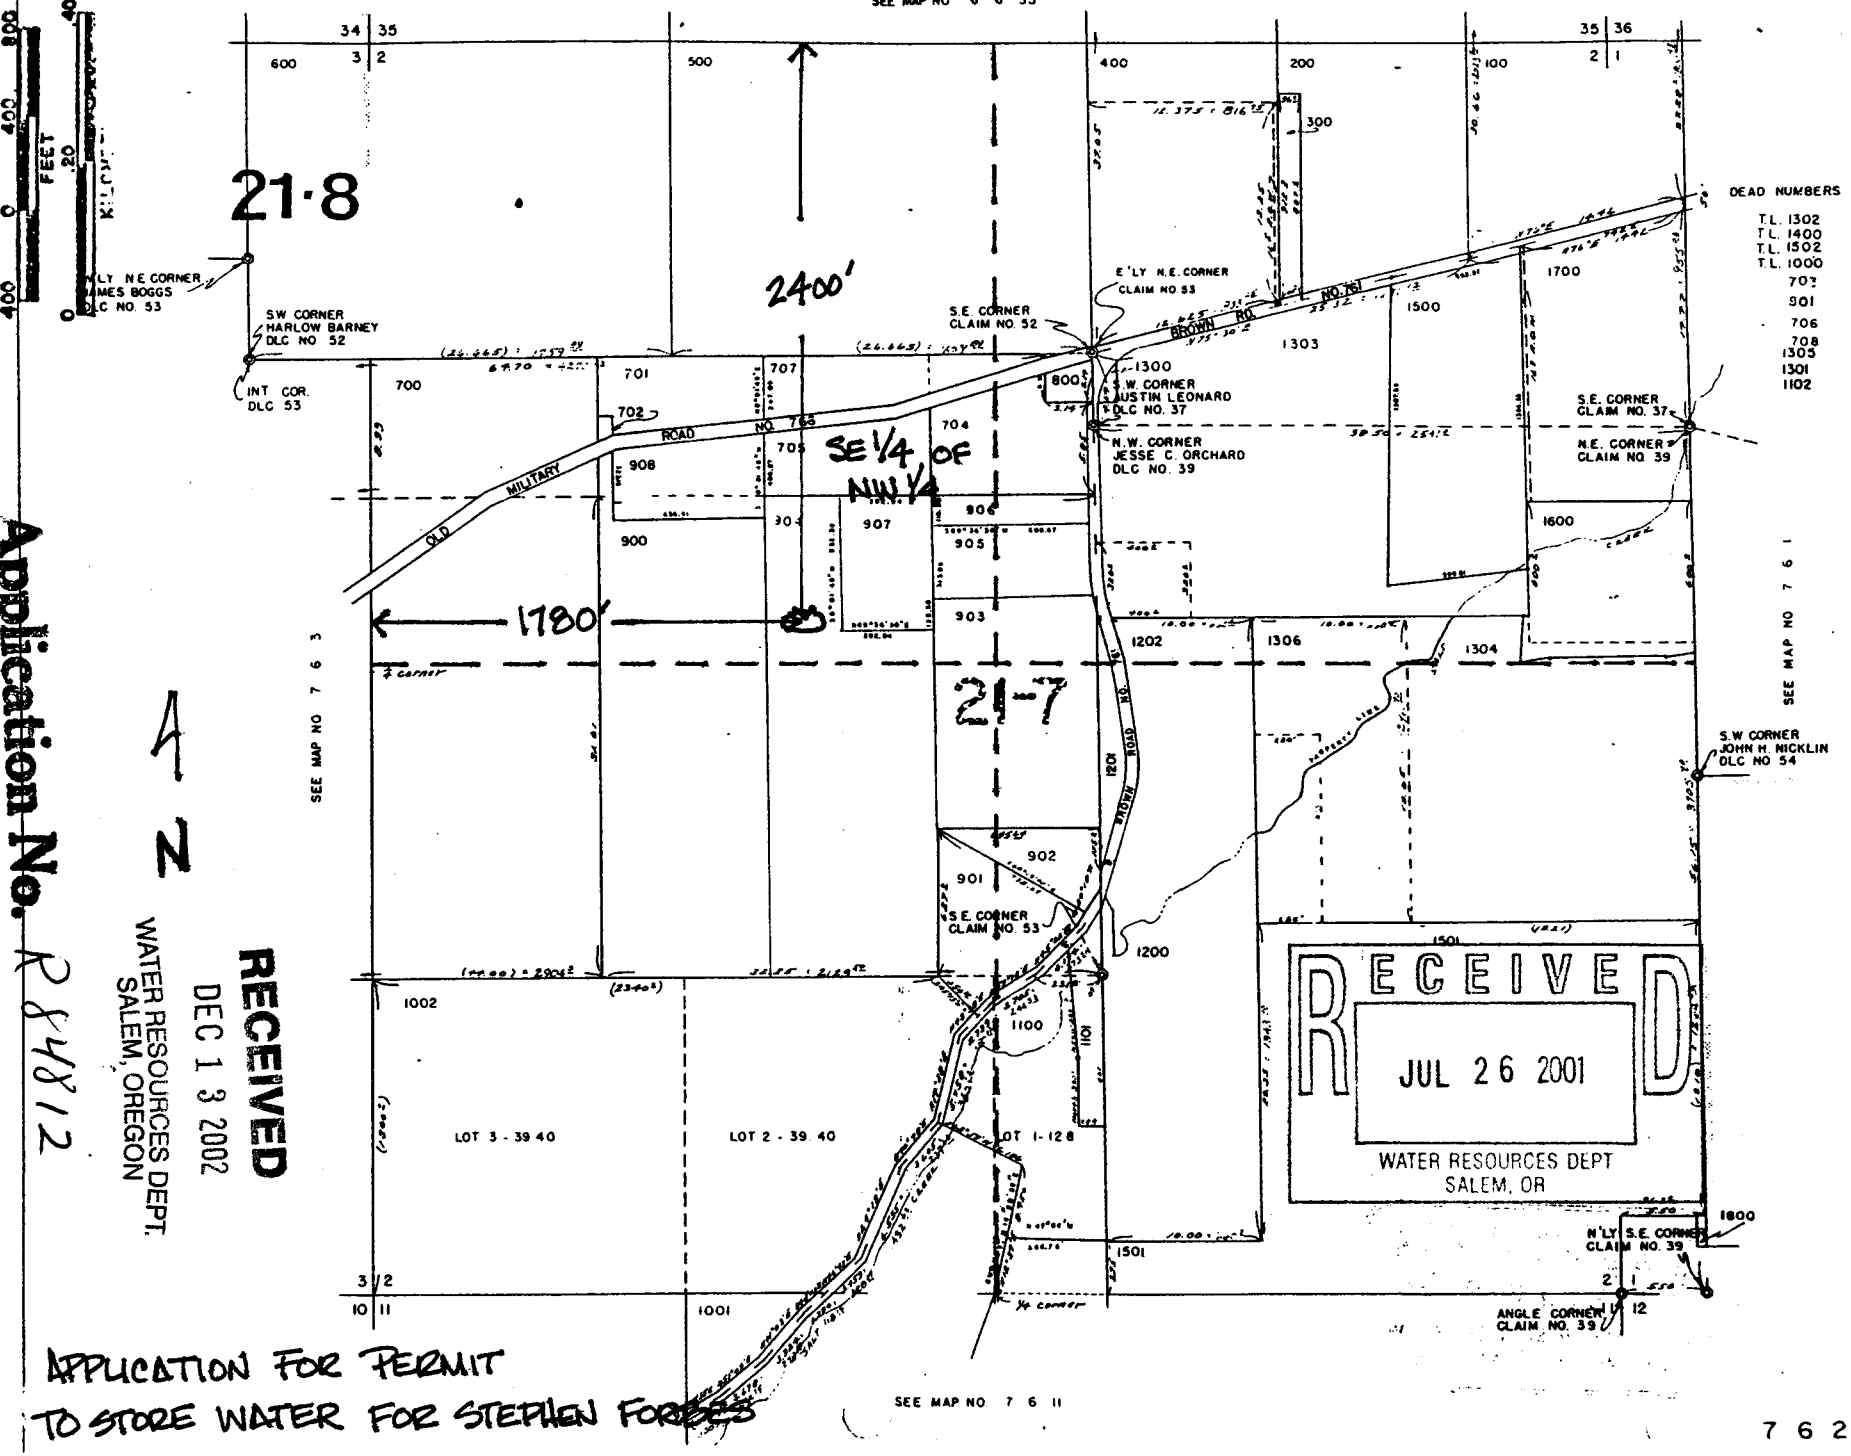

RECEIVED
DEC 13 2002
WATER RESOURCES DEPT.
SALEM, OREGON

RECEIVED
JUL 26 2001
WATER RESOURCES DEPT
SALEM, OR

Application No. R 84812
Permit No. R-13296

APPLICATION FOR PERMIT
TO STORE WATER FOR STEPHEN FORBES