

First American Title Insurance Company of Oregon

An assumed business name of TITLE INSURANCE COMPANY OF OREGON

1700 S.W. FOURTH AVENUE, PORTLAND, OR 97201-5512
(503) 222-3651

RECEIVED

OCT 10 2000

WATER RESOURCES DEPT.
SALEM, OREGON

T.T.-2

R.R.F.F.-5

RECEIVED

JAN 08 2001

WATER RESOURCES DEPT.
SALEM, OREGON

RECEIVED


OCT 25 2000

WATER RESOURCES DEPT.
SALEM, OREGON

RECEIVED

APR 10 2002

WATER RESOURCES DEPT.
SALEM, OREGON

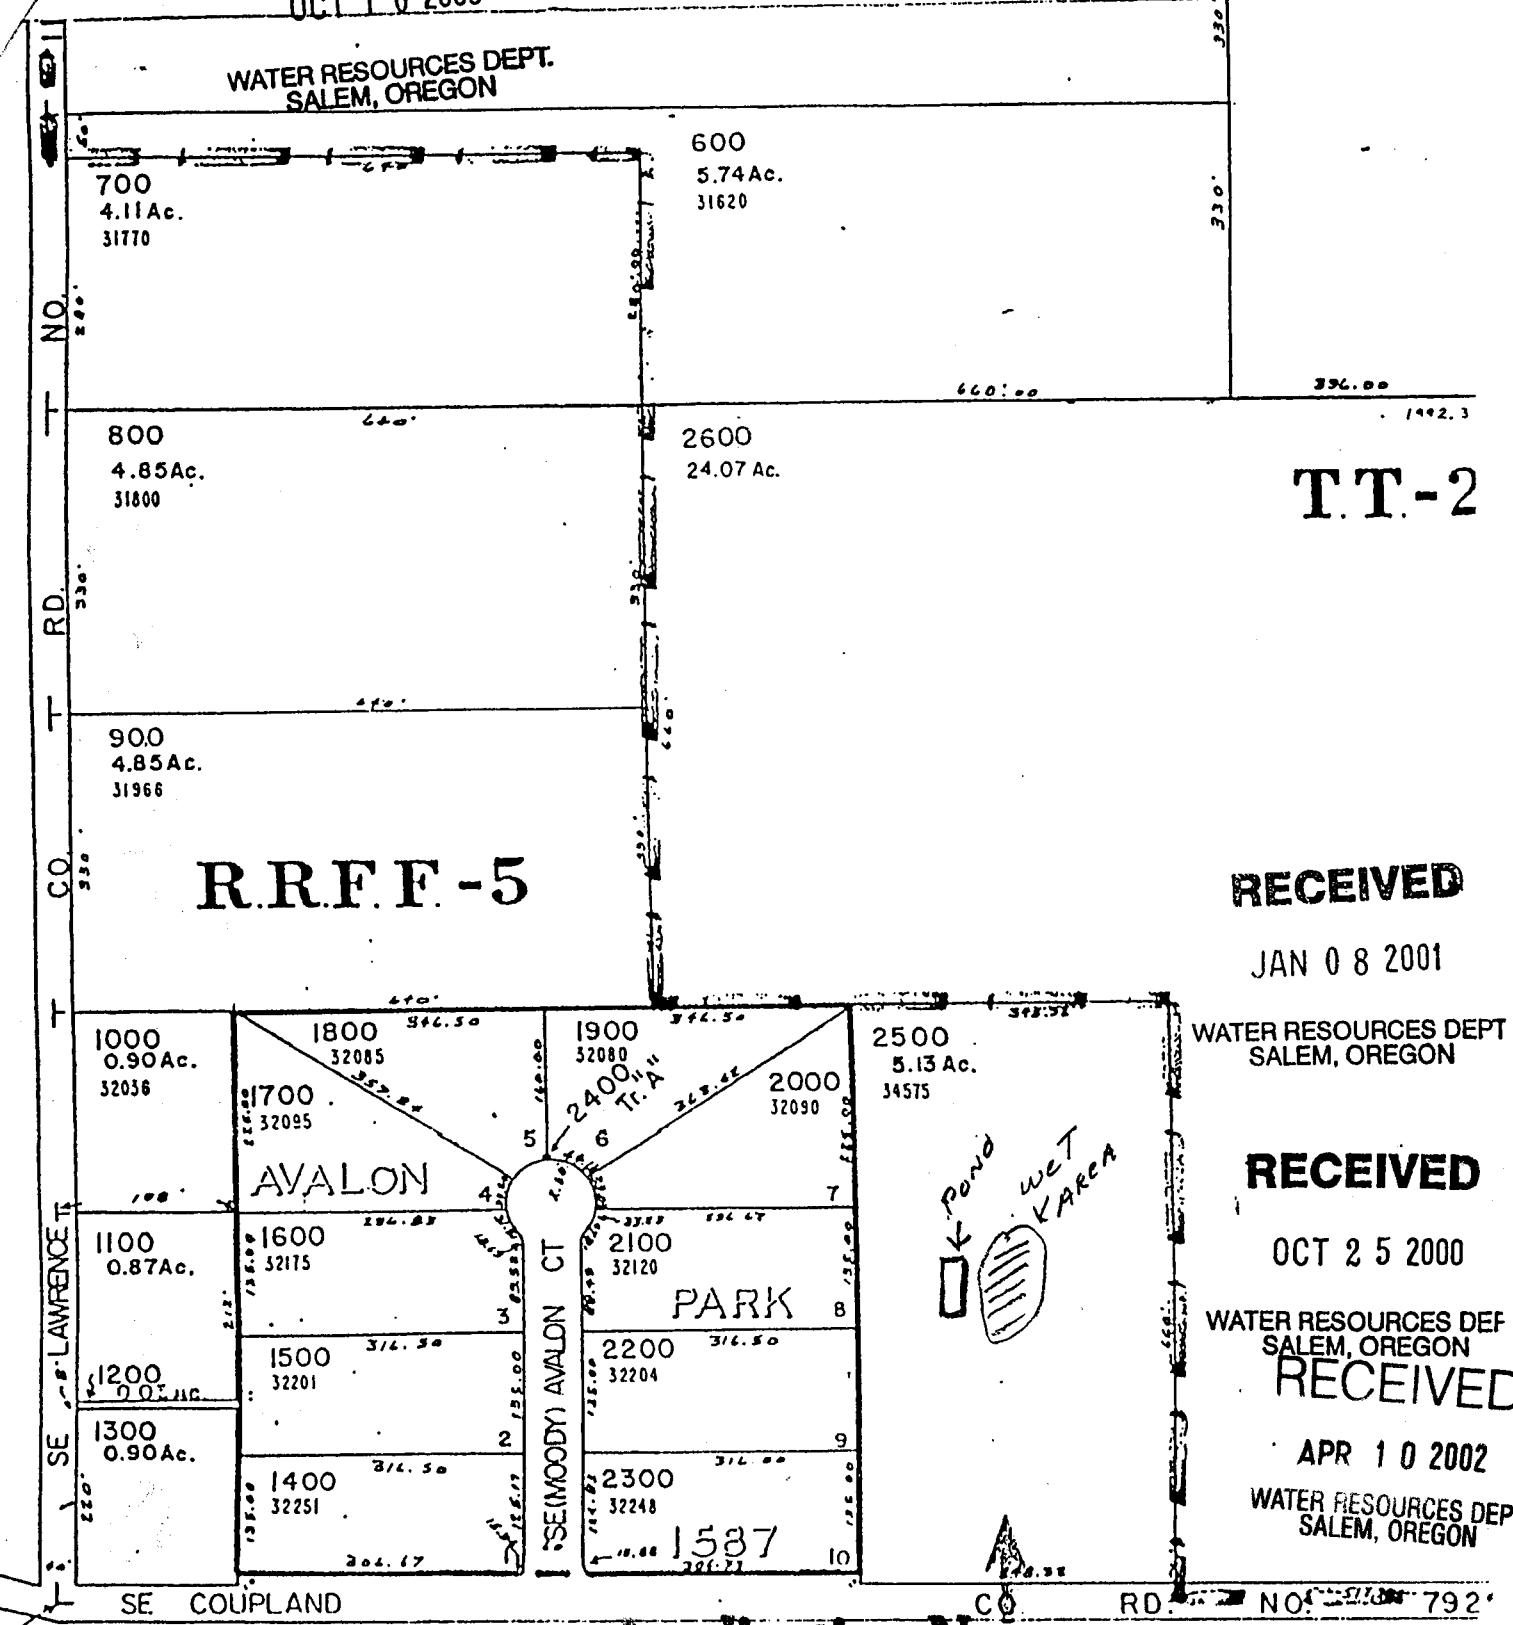

NO.63

T35 R4E Sec.22


R3 4E22C

SW 1/4 SW 1/4


Application No. R-84570

Permit No. R-13064

SEE MAP 3 41

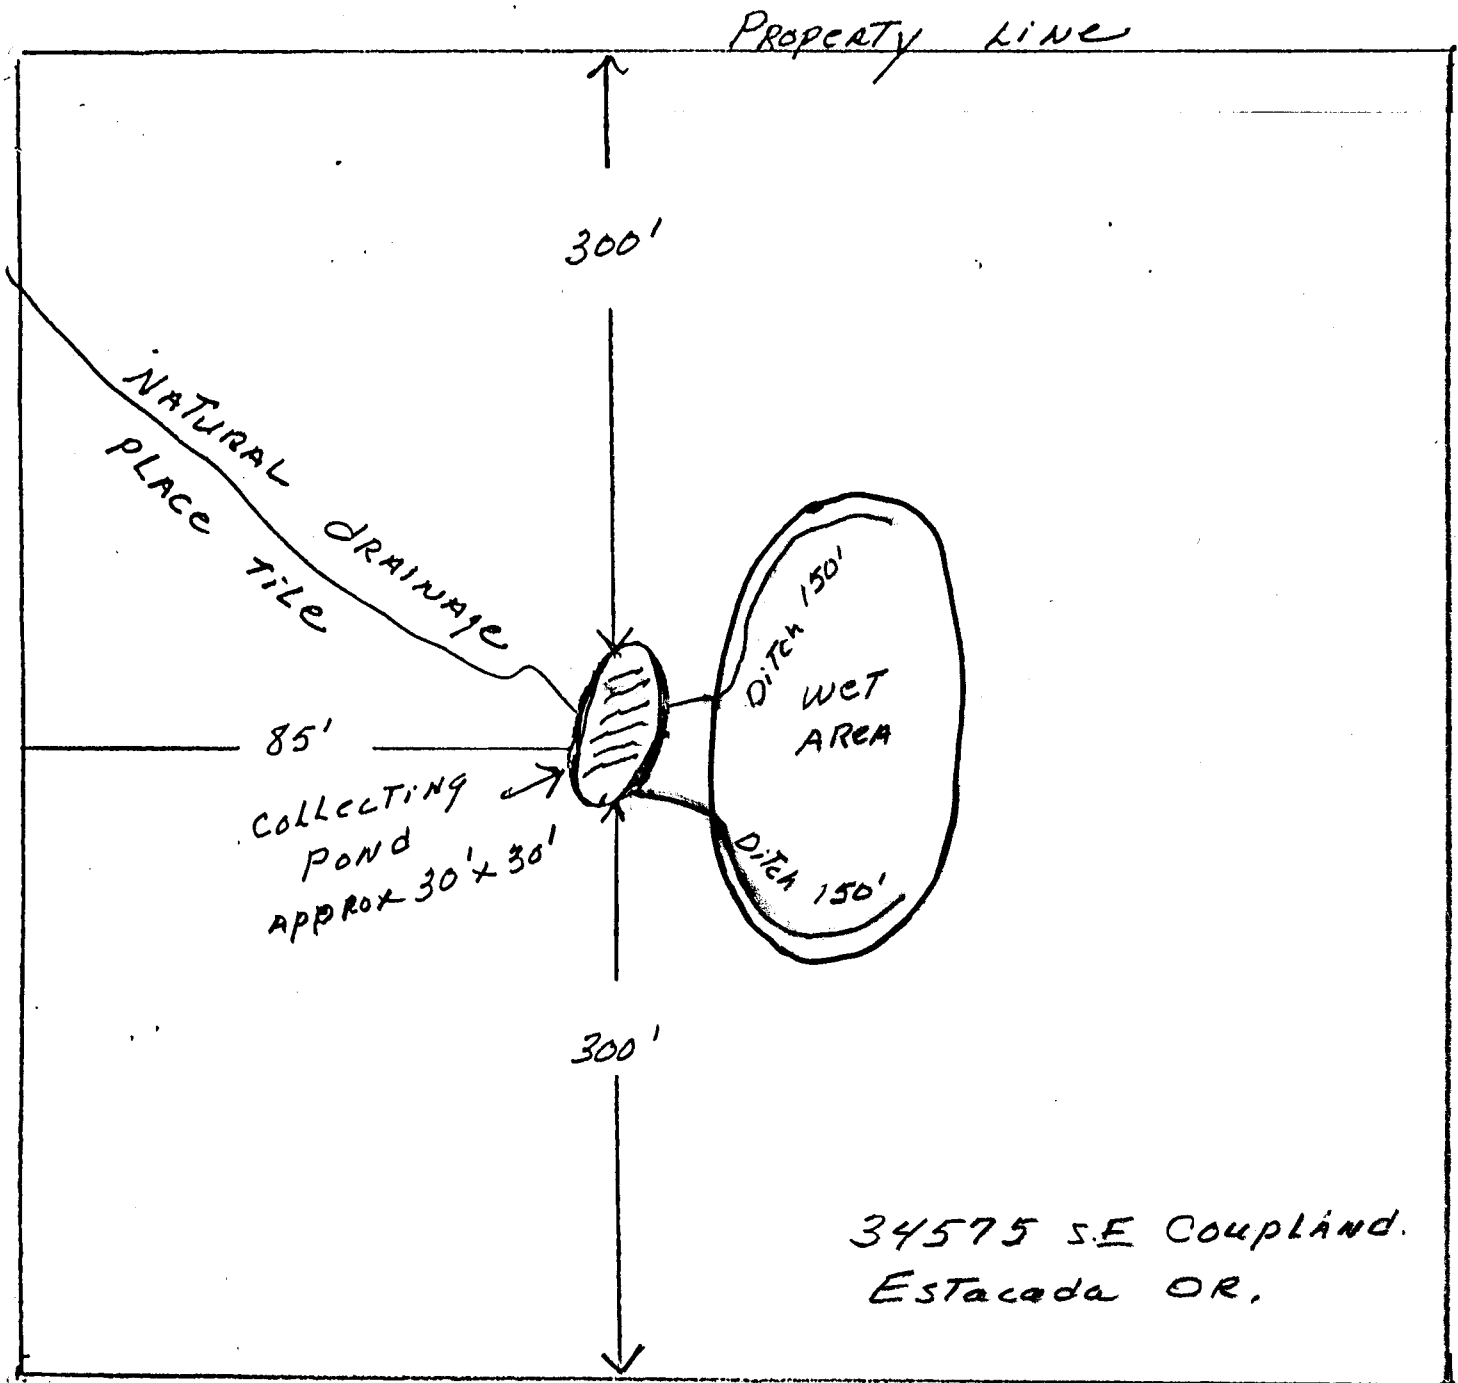

SE. COUPLAND ROAD.

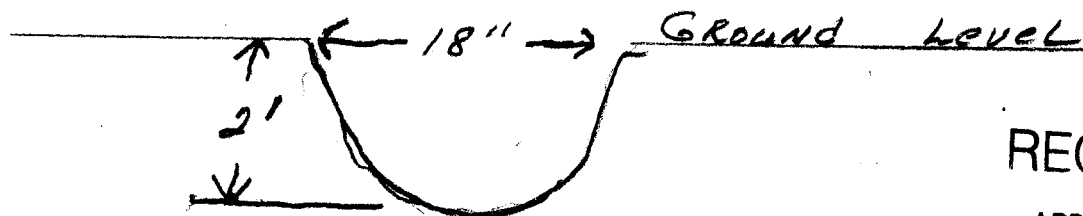

Application No. R-84570

Permit No. R-13064

Cross section of Ditch

RECEIVED

APR 10 2002

WATER RESOURCES DEPT.
SALEM, OREGON