

Legal Property ID: Township 37, Range 4W, Section 14, Tax Lot 800

Property Owners: Martha & Allen Dobney
43638 Skye Road
Fremont, CA 94539


RECEIVED

OCT 07 2002

WATER RESOURCES DEPT.
SALEM, OREGON

Property Mail Address: 3366 Foots Creek Road
Gold Hill, Oregon 97525

Scale: 1" = 200'

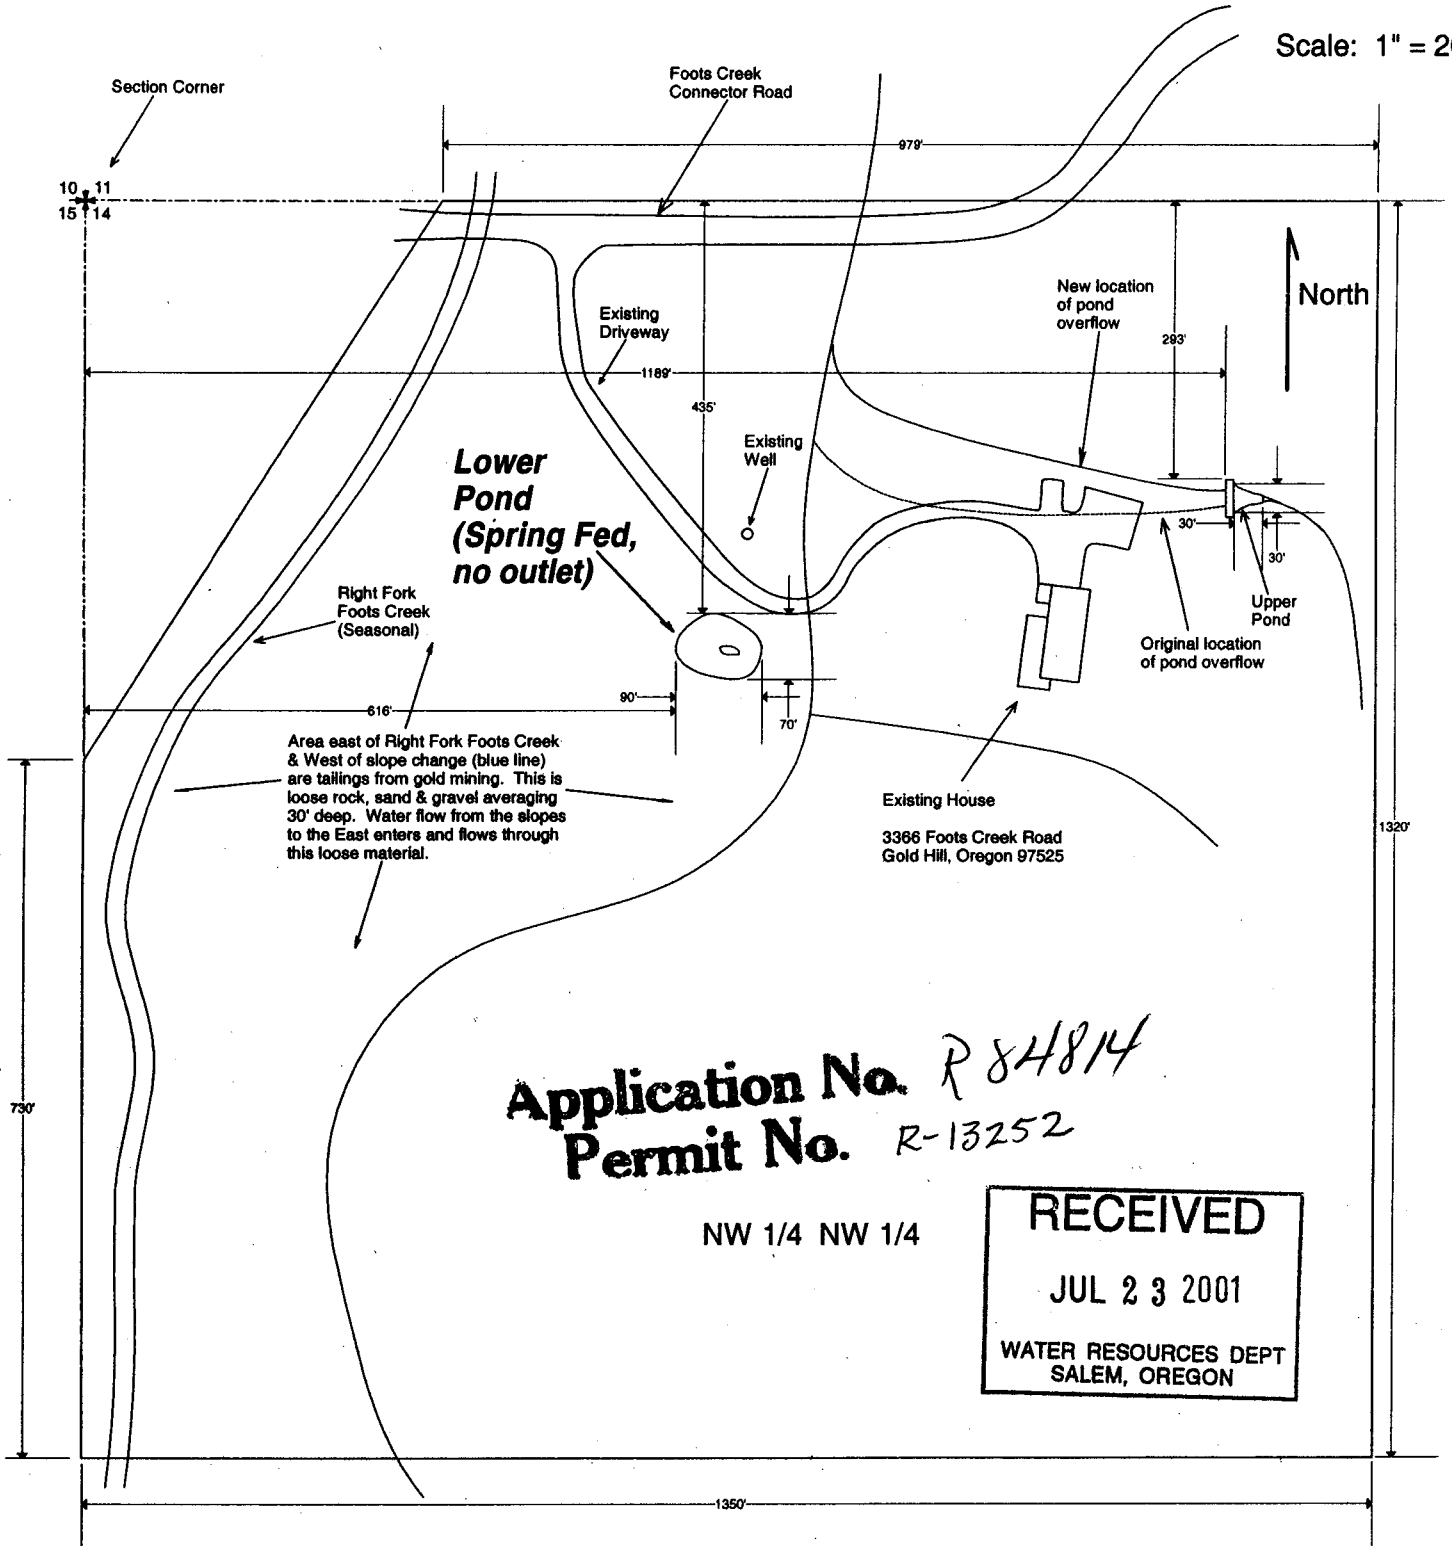

Application No. R 84814
Permit No. R-13252

NW 1/4 NW 1/4

RECEIVED
JUL 23 2001
WATER RESOURCES DEPT
SALEM, OREGON

Prepared: May 26, 2001