

Legal Property ID: Township 37, Range 4W, Section 14, Tax Lot 800

RECEIVED

Property Owners: Martha & Allen Dobney  
43638 Skye Road  
Fremont, CA 94539


OCT 07 2002

WATER RESOURCES DEPT.  
SALEM, OREGON

Property Mail Address: 3366 Fooths Creek Road  
Gold Hill, Oregon 97525

RECEIVED  
JUL 23 2001  
WATER RESOURCES DEPT.  
SALEM, OREGON

Scale: 1" = 200'

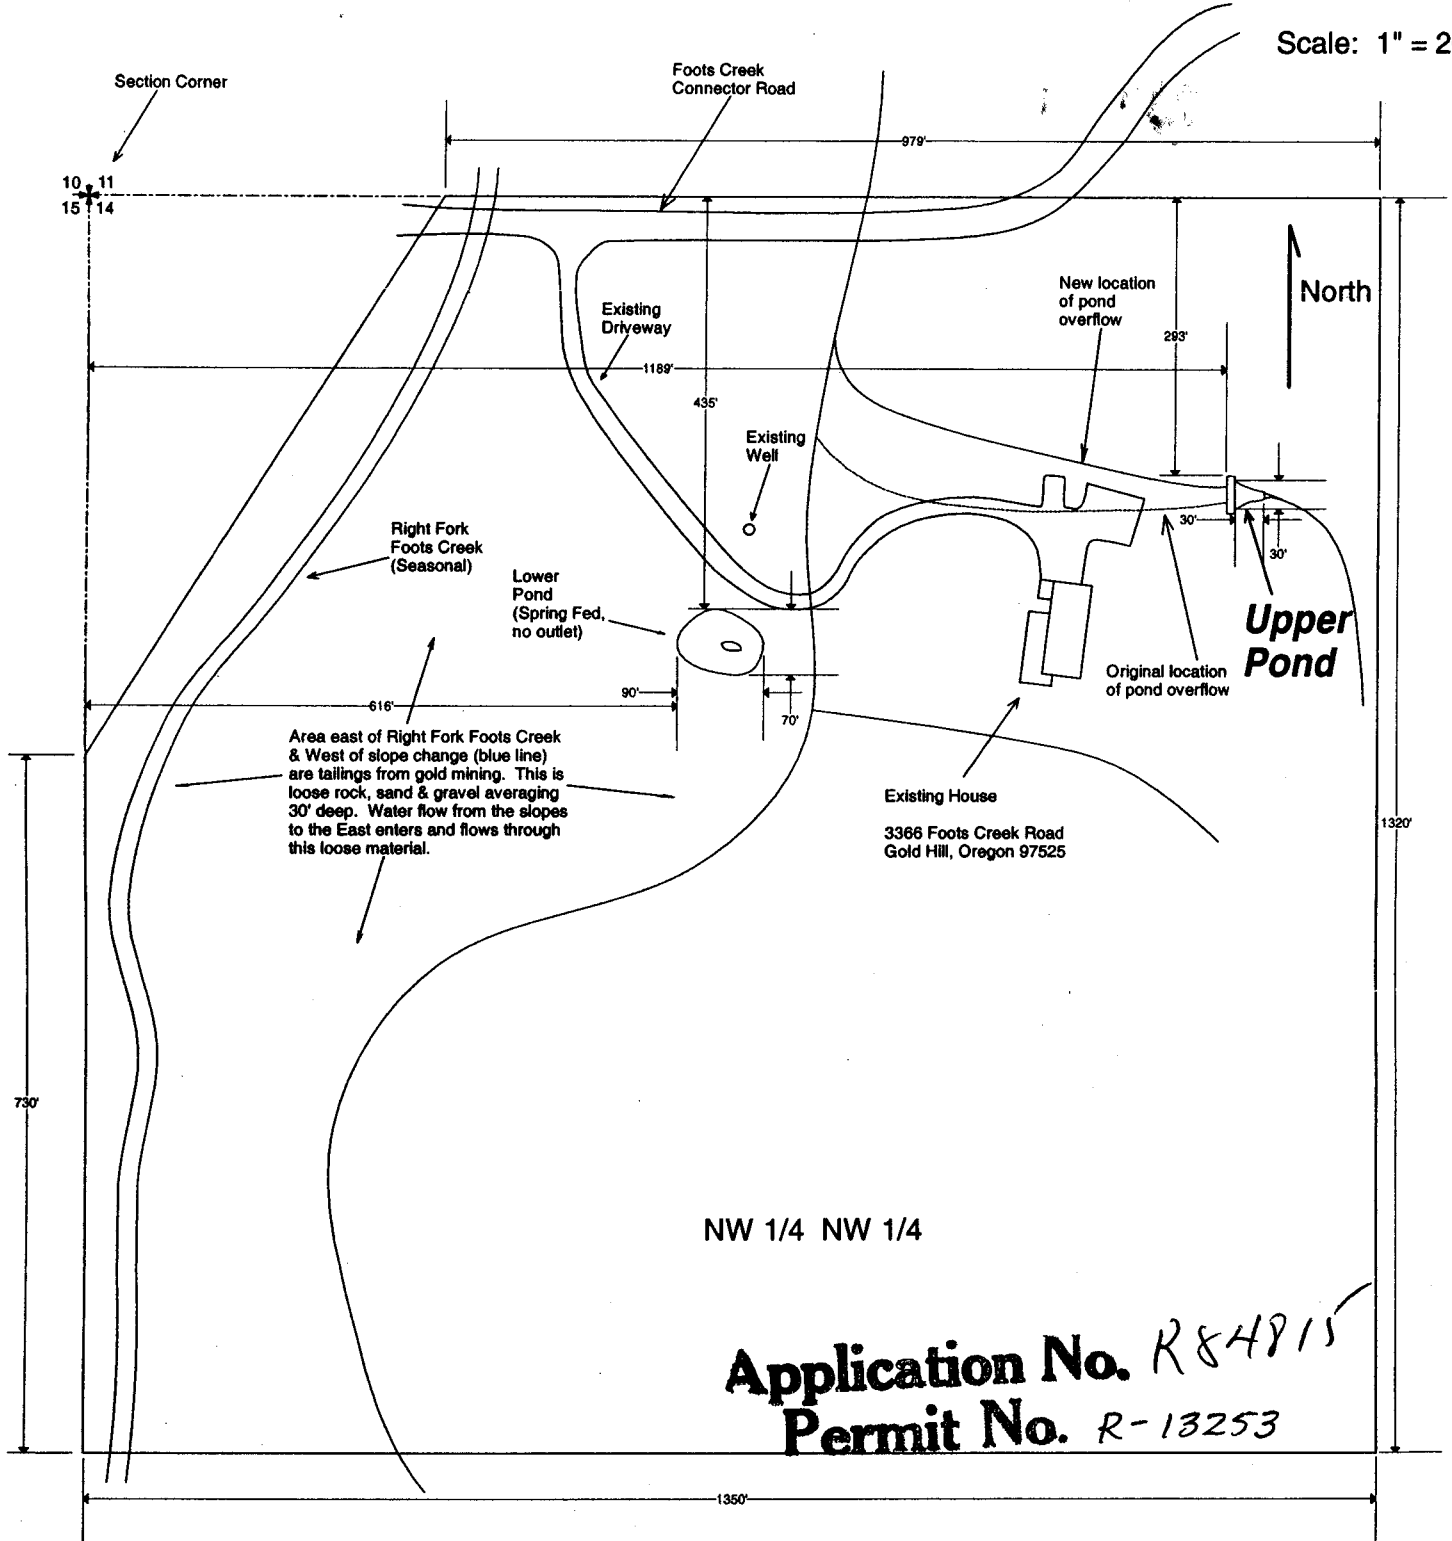

Prepared: May 26, 2001