


Haarberg Pond

1" = 1000 Ft.

Location - T12S, R15E Sec 34, SE 1/4, SE 1/4
1150' N & 935' W from SE corner Section 34
W N 4/2/02

-  Gravel Roads
-  Haarberg Dam
-  Haarberg Pond
-  Taxlots
-  Intermittent Streams
-  Sections

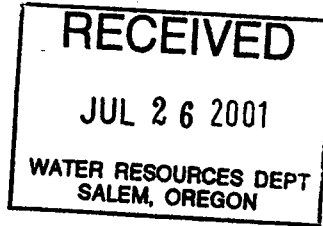

RECEIVED

JAN 23 2003

WATER RESOURCES DEPT.
SALEM, OREGON

Application No. R84818
Permit No. R13316

813
34
County Road

Tax Lot 3800
646.36 AC.

35

Newbill
AS BUILT

160 FT
13 FT DEEP
145 FT
AUG.
420 FT
AUG.


Tax Lot 3900
100.00 AC.

Tax Lot 3801
90.00 AC.

Jefferson Co.
Crook Co.

Tax Lot 200
245.00 AC

T12S, R15E
T13S, R15E

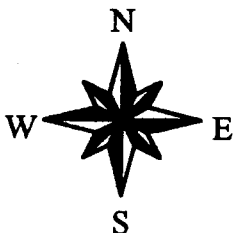

500 0 500 1000 Feet

