

RECEIVED


NOV 25 1998

WATER RESOURCES DEPT.
SALEM, OREGON

OCT 21 1998

WATER RESOURCES DEPT.
SALEM, OREGON

T 29 S, R 34 E, WM

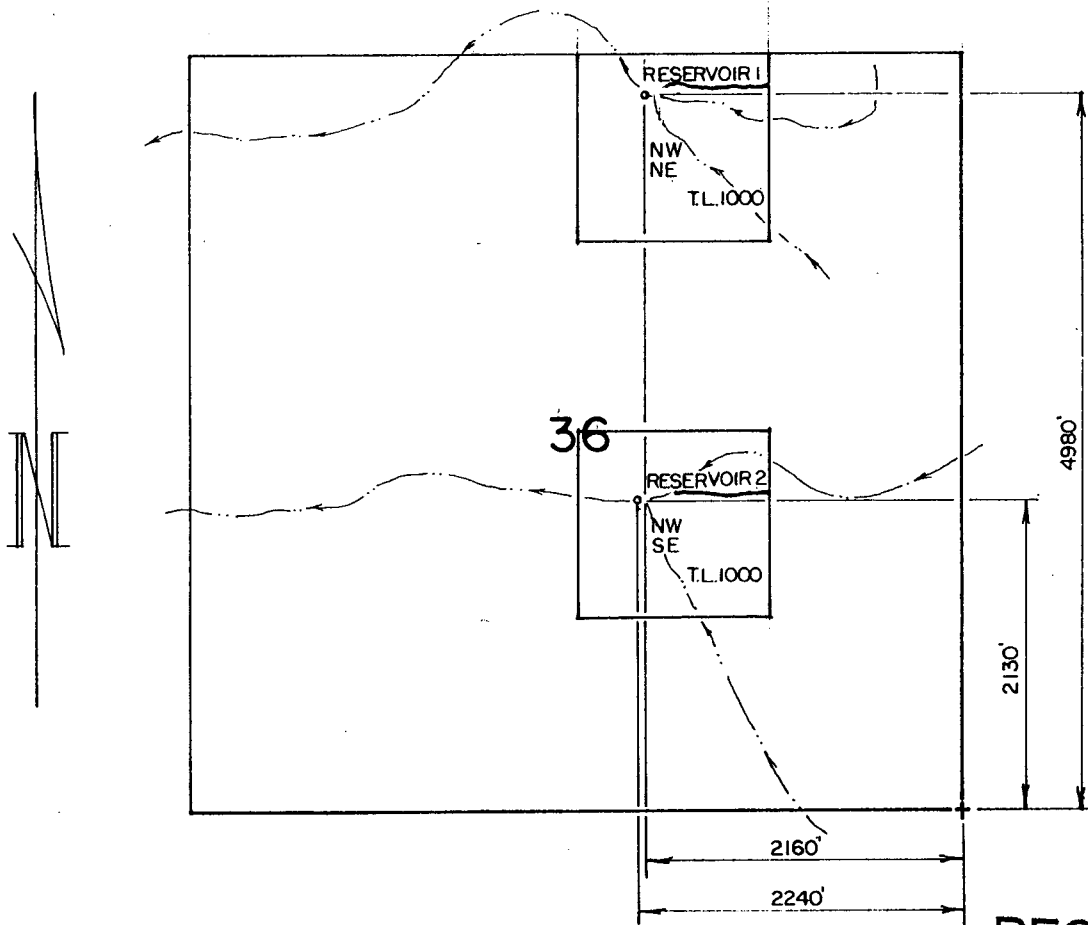

Application No. R-84011

Permit No. R-12749


RECEIVED

DEC 28 2001

WATER RESOURCES DEPT.
SALEM, OREGON

RIDDLE RANCH, INC

WATER RIGHT APPLICATION MAP

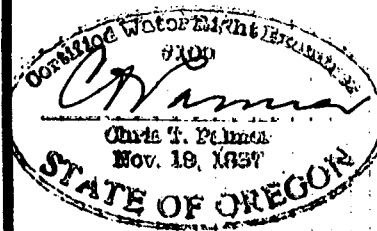

Scale: 4" = 1 MILE

Date: OCT. 1998

Job: 1796

Desn:

Drm: CHRIS

Ckd:

MAP's

M. A. PALMER & SONS, INC.
ENGINEERING & SURVEYING
254 N. Alder - Box 61
Burns, Oregon 97720

Sht. No.

of 1

RENEW 1-1-1999

N.

Application R-84011 Permit R-12749


NW $\frac{1}{4}$ NE $\frac{1}{4}$

Section 36

Township 29 south, Range 34 East, W.M.

W.

E

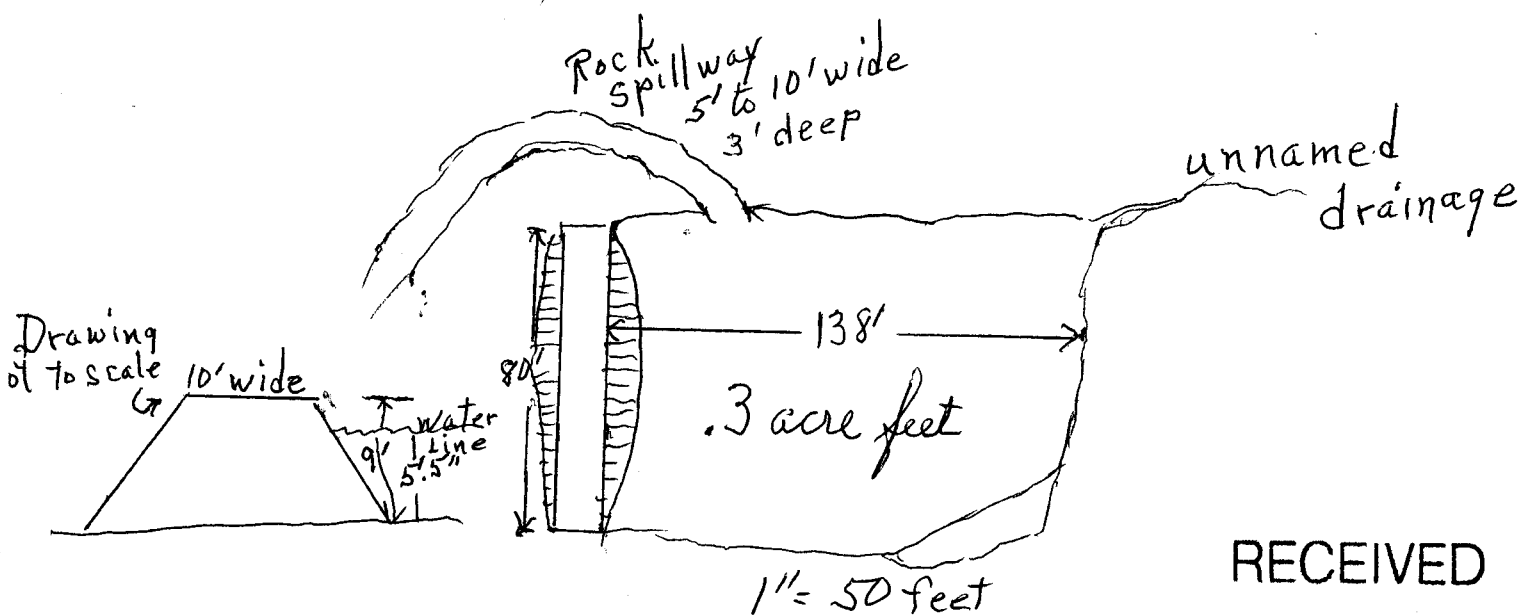

RECEIVED

DEC 28 2001

WATER RESOURCES DEPT.
SALEM, OREGON

S