


RECEIVED  
 JAN 10 2003  
 WATER RESOURCES DEPT.  
 SALEM, OREGON

376 5455

8 4

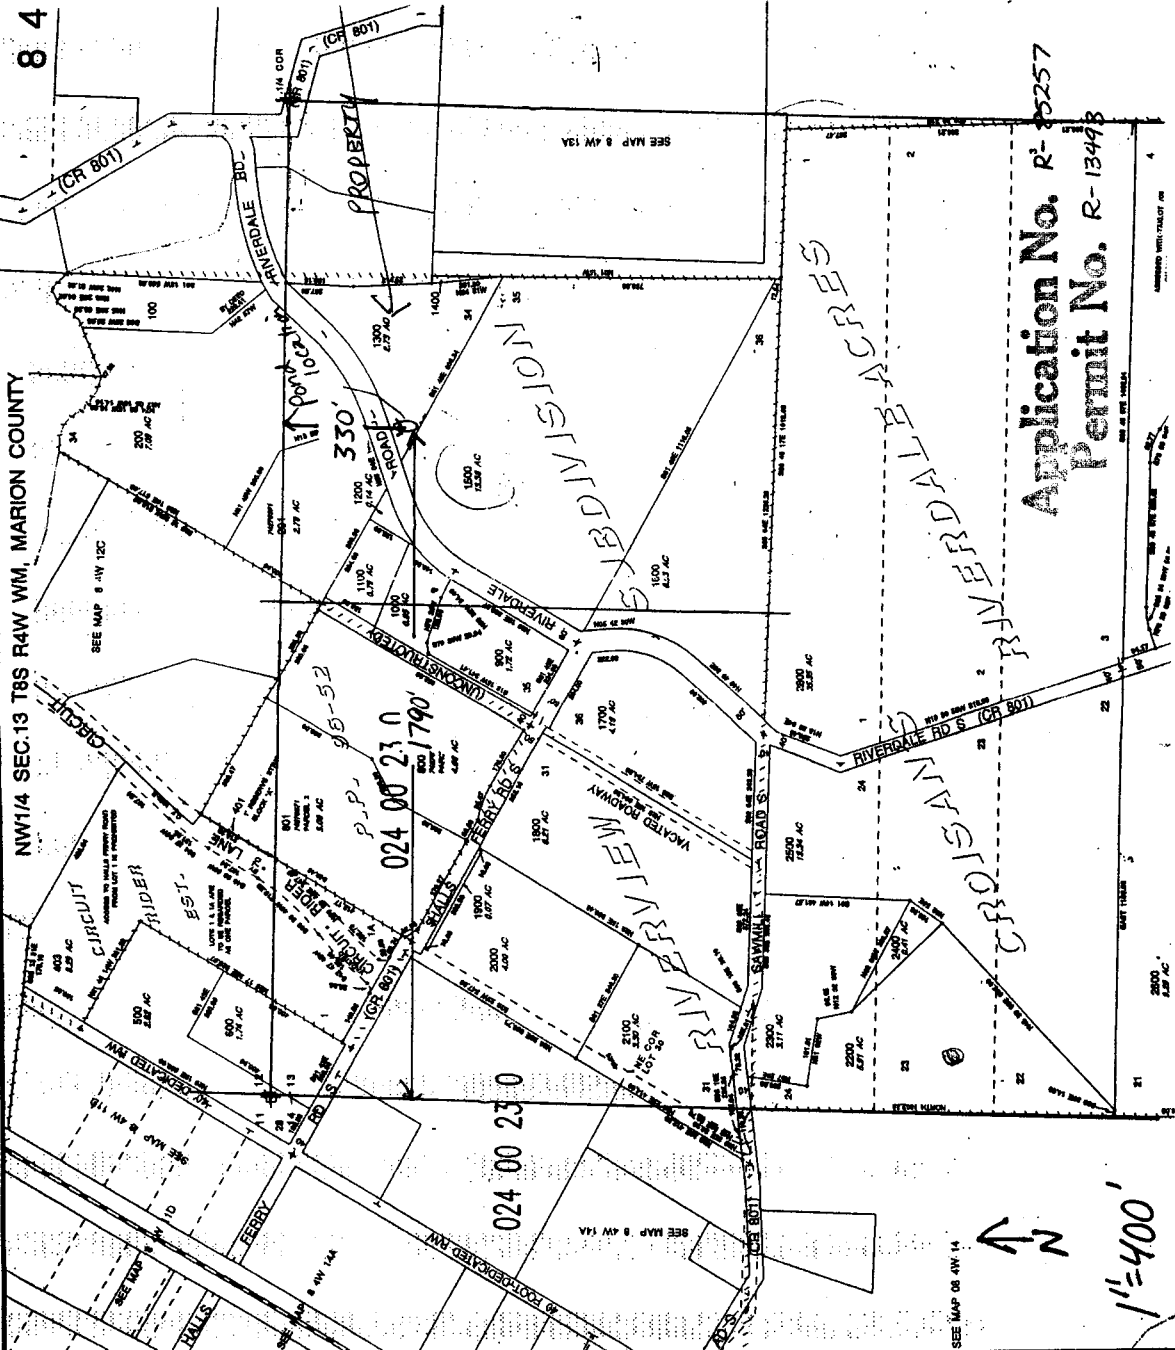

Application No. R-25257  
 Permit No. R-13498

LEGEND

- LINE TYPES**
- TAX LOT BOUNDARY
  - OLD PROPERTY LINE
  - PAVED RIGHT-OF-WAY
  - UNPAVED RIGHT-OF-WAY
  - RAILROAD
  - RAILROAD RIGHT-OF-WAY
  - STREAM, LAKE, ETC.
  - STREAM, LAKE, ETC. BOUNDARY
  - BOUNDARY BOUNDARY
  - SECTION PLAT INT.
  - TAX CODE BOUNDARY
  - BASEMENT

SYMBOL TYPES

- B.L.C.
- CONTROL POINTS
- SURVEY MONUMENTS
- Q.L.A. CORNERS
- 1/4 SEC.
- 1/8 SEC.
- 1/16 SEC.


NUMBERS

- TAX CODE NO.
- 000 00 00 0
- ACREAGE - ALL ACREAGE SHOWN IS APPROXIMATE AND MAY VARY FROM THE REGISTERED PUBLIC RIGHT OF WAY.
- TRUCK MARKER - WHEN A TRUCK MARKER IS SHOWN ON THE EXTENSION OF A LINE, THE TRUCK MARKER IS TO BE USED FROM BOUNDARY OR INTO PUBLIC RIGHT OF WAY.
- LANDS ARE USED WITH BOUNDARIES IN AREAS OF GREATER COMPLEXITY.

NOTICE: This map was created for Assessor's Office use ONLY.



SEE MAP 08 4W 14

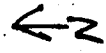

1"=400'