


FROM COMMON SECTIONS
29, 30, 31, 32

1650 FT EAST
2480 FT SOUTH




Scale 1 in = 400 ft

SEE MAP
15329

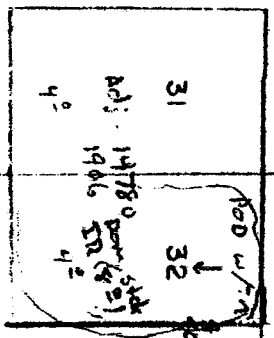

15-6

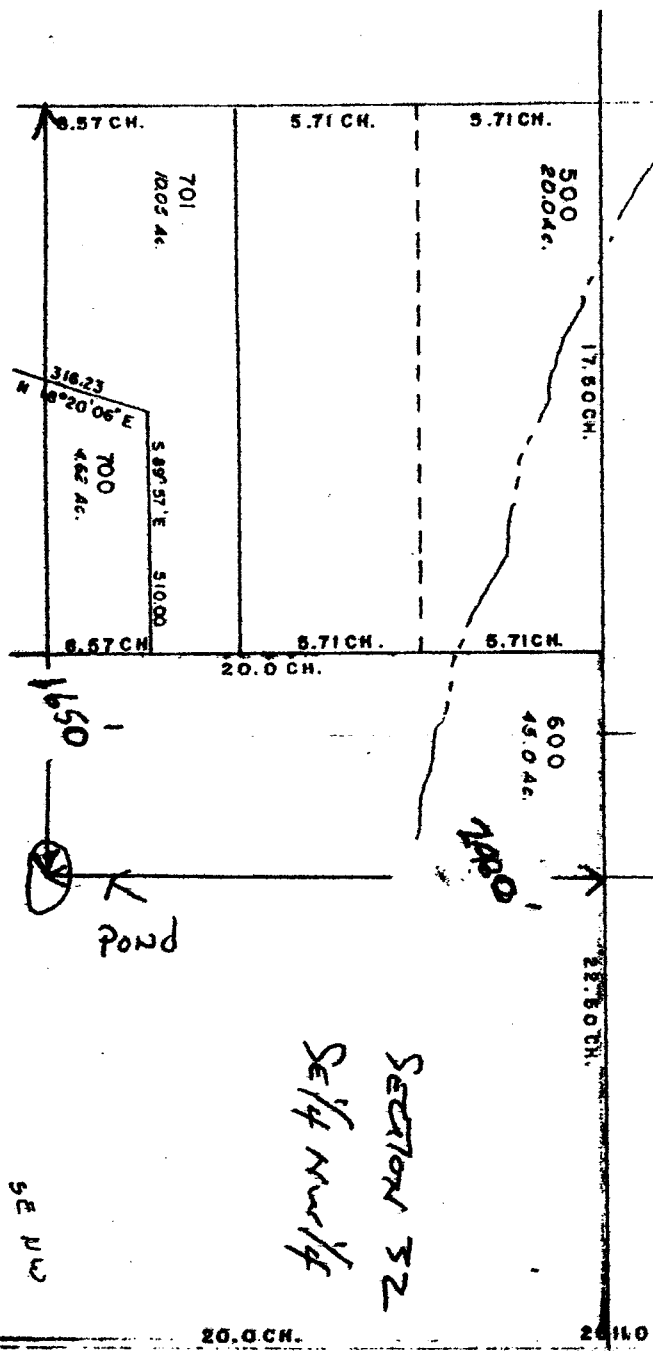

SECTION 32
SE 1/4 NW 1/4

map 15332

RECEIVED

FEB 19 2003

WATER RESOURCES DEPT.
SALEM, OREGON

RECEIVED

AUG 19 2002

WATER RESOURCES DEPT.
SALEM, OREGON

OPP # R-852
Permit # R 13518