

WATER RESOURCES DEPT.  
SALEM, OREGON

SEP 1 1 2000

RECEIVED

40.2

15  
2501  
20.3 AC.

14  
2502  
19.35 AC.

2500  
80.3 AC.

Woodard

Woodard

Wilson

2400  
70.0 AC.

2300  
7.56 AC.

2200  
5 AC.

4100  
5.14 AC.

4200  
5.08 AC.

4300  
3.15 AC.







T 4S R 5 W Sec. 14

NW 1/4 SE 14

Application No. R-73813

Permit No. R-11657

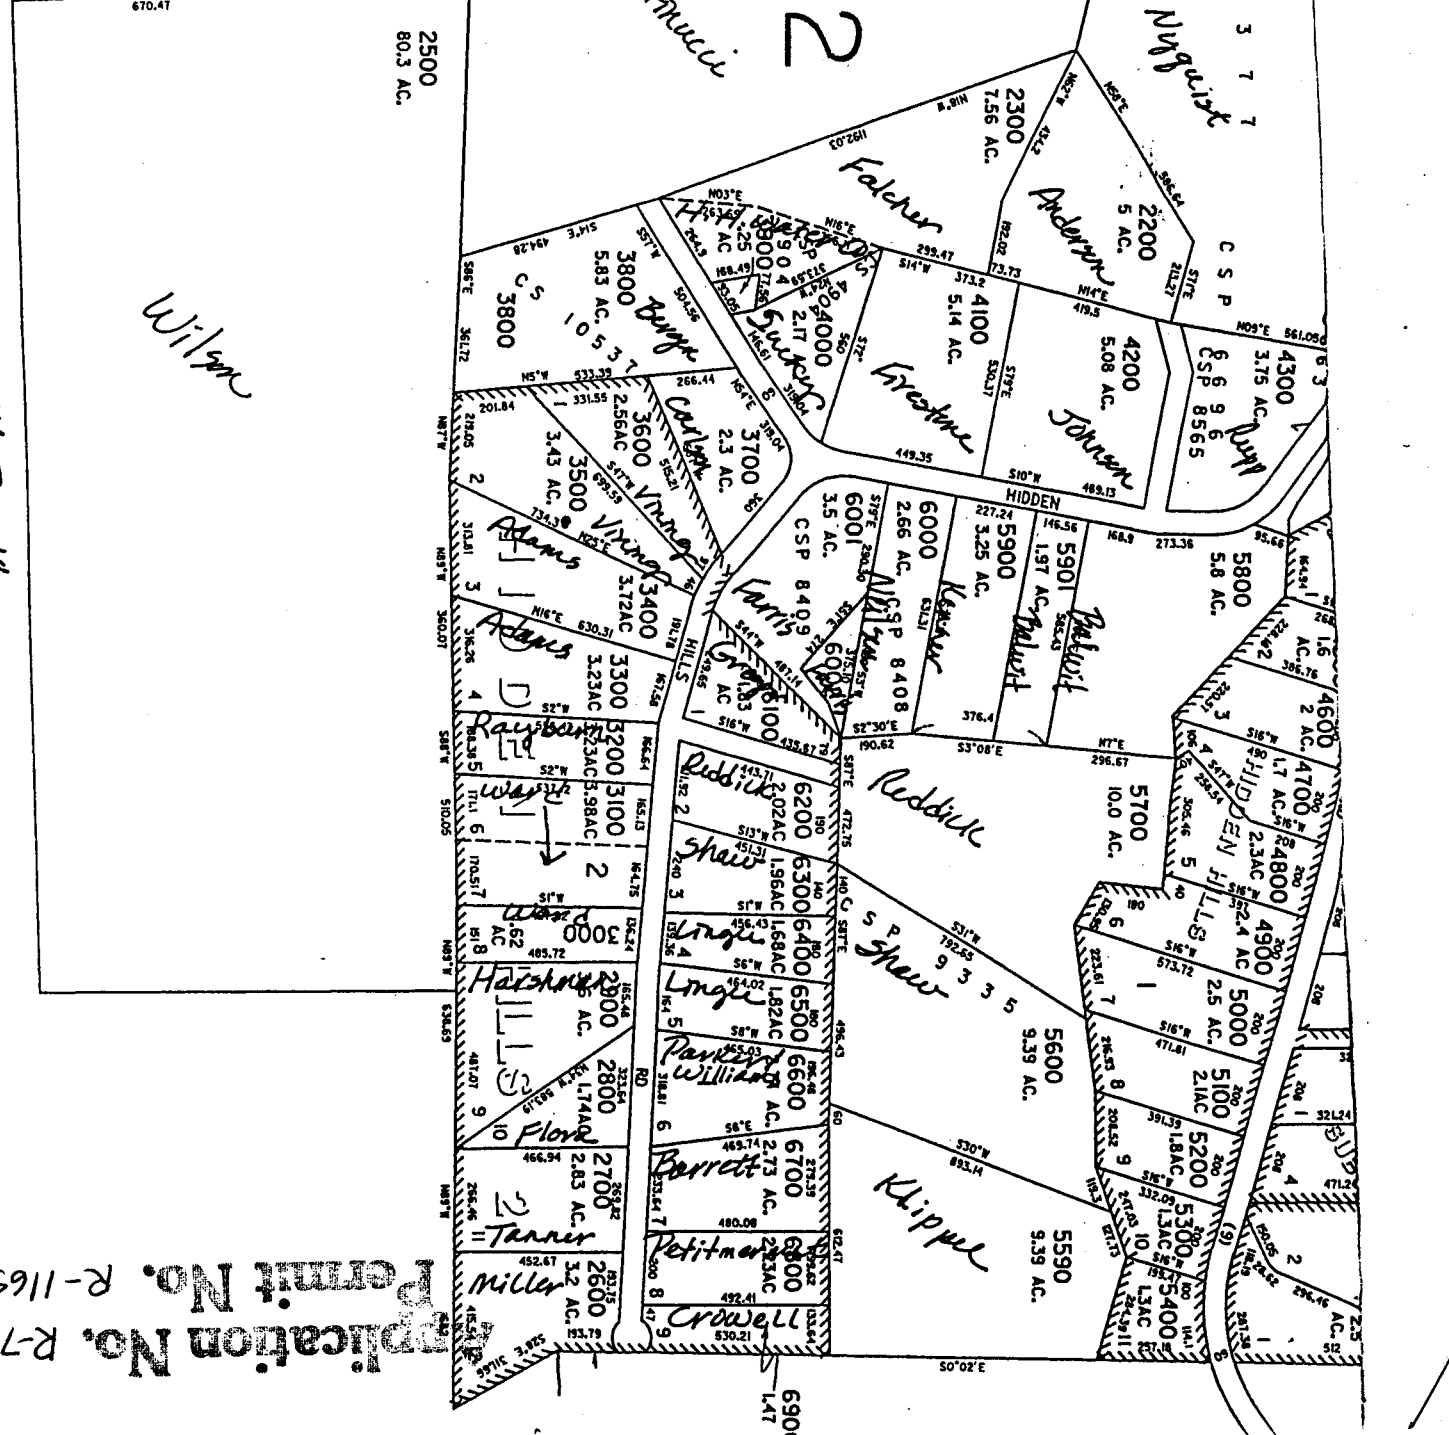




Scale

1" = 100'

Application No. R-73813  
Permit No. R-11657

T45 R5W Sec. 14  
NW<sup>1</sup>/<sub>4</sub> SE<sup>1</sup>/<sub>4</sub>

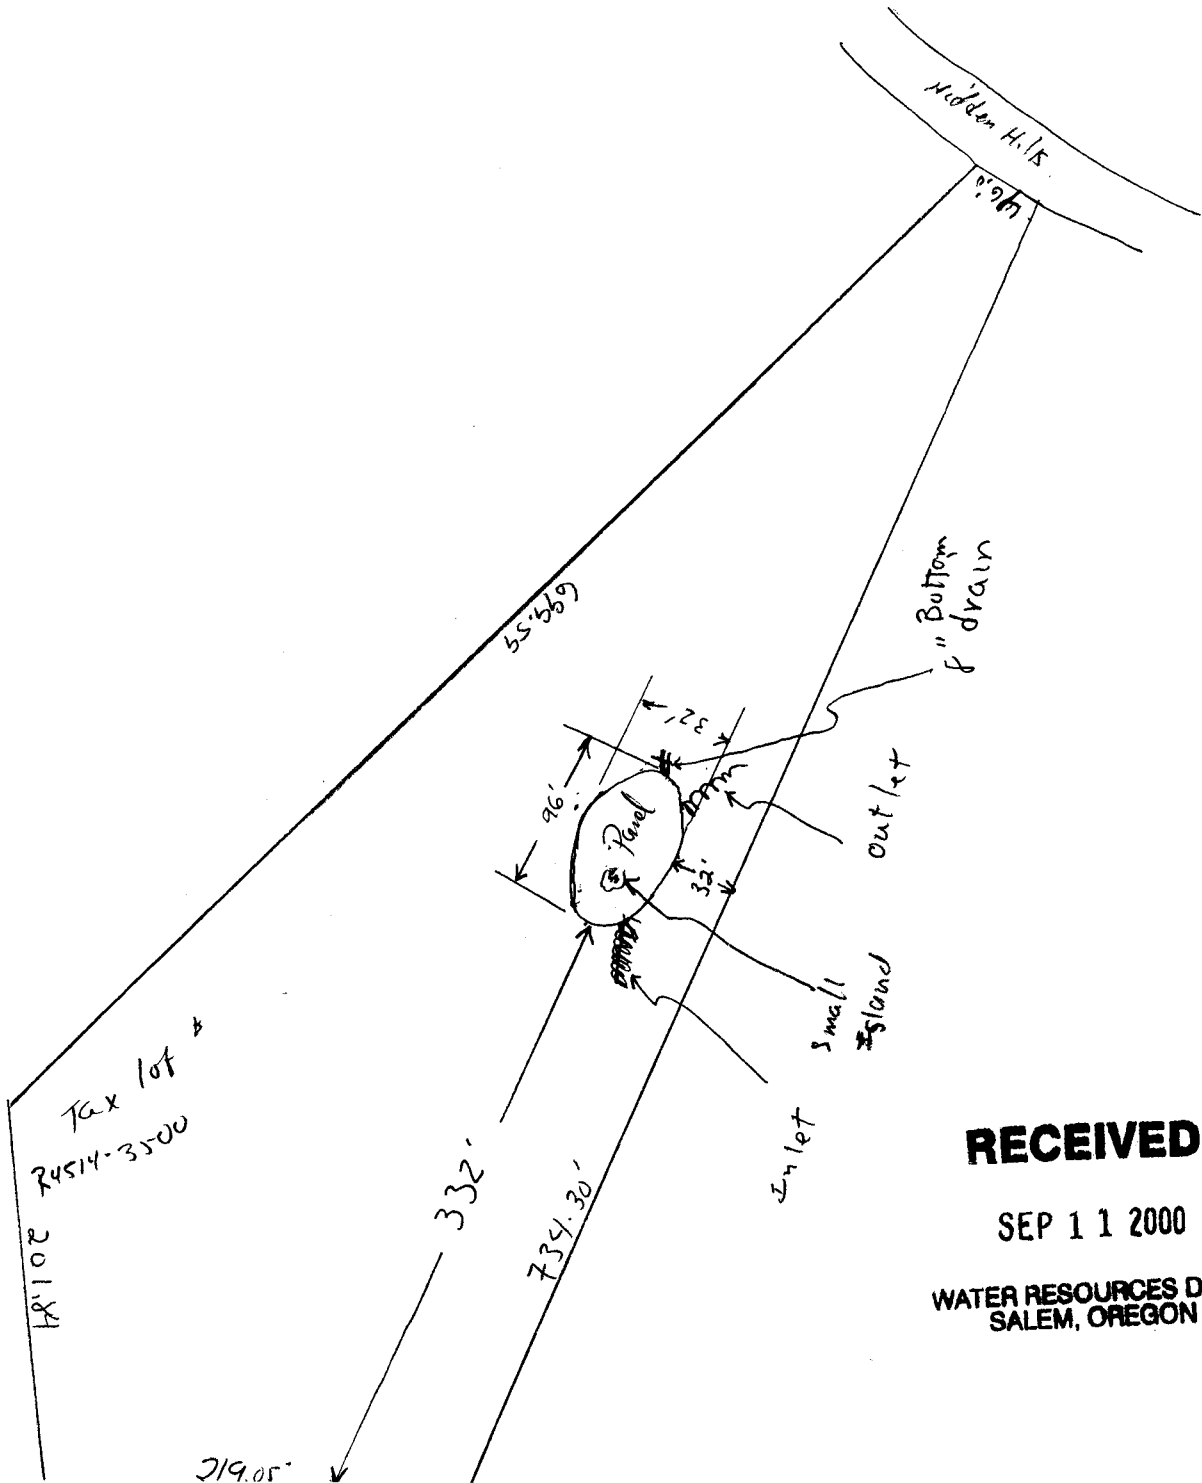

**RECEIVED**

SEP 11 2000

WATER RESOURCES DEPT.  
SALEM, OREGON