

SEE MAP No. 6635

SCALE: 1" = 400' - 0"



Range 6w, w.m.

Township 6S

Range 6w, w.m.

Township 7S

New York, NE 1/4
North Half of Section 2
T.S. 1S, R. 6w., w.m.

35

2

New York, NE 1/4
North Half of Section 2
T.S. 1S, R. 6w., w.m.


RECEIVED

SEP 18 2000

WATER RESOURCES
SALEM, OREGON DEPT.

POINT OF DIVERSION LOCATION:
NE 1/4, New York, Section 2, T. 7S, R. 6w., w.m.
PLACE OF USE: 0500 TAXLOT Polk County

MULTIPLES: OFFSTREAM CATTLE WATER,
AQUATIC, AND FIRE PROTECTION, WILDLIFE.

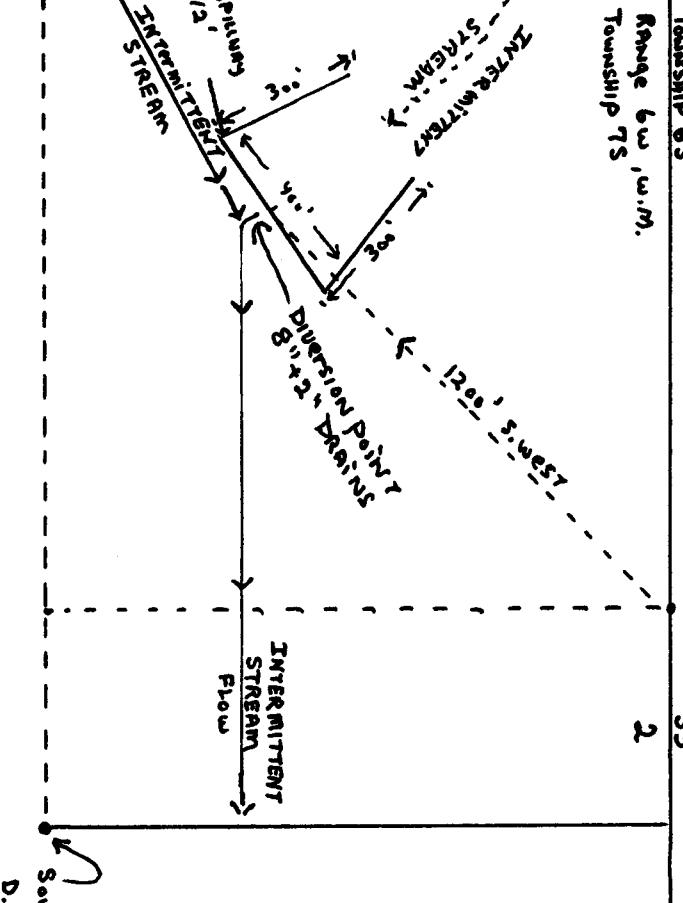

APPLICATION # R-81475

PERMIT # R-12146

DAM HEIGHT 11.0
DAM LENGTH 400.0'
DAM HEIGHT Full Pool 7.7'
Reservoir Length 300.0'

Formula used:
 $.4 \times 2.75 \times 7.7 = 8.47$ ACRE FEET

Legal Des.
The EAST half of the DONATION LAND
CLAIM of Harlow Barney; wife,
NOTIFICATION # 5206 Being claim # 92
In T.S. 6 South, Range West of
Willamette Meridian, and claim
52 In the T.S. 7 South, Range West
of the Willamette Meridian.