


RECEIVED
OCT 29 2001
WATER RESOURCES DEPT.
SALEM, OREGON

NOV 13 1996
WATER RESOURCES DEPT.
SALEM, OREGON

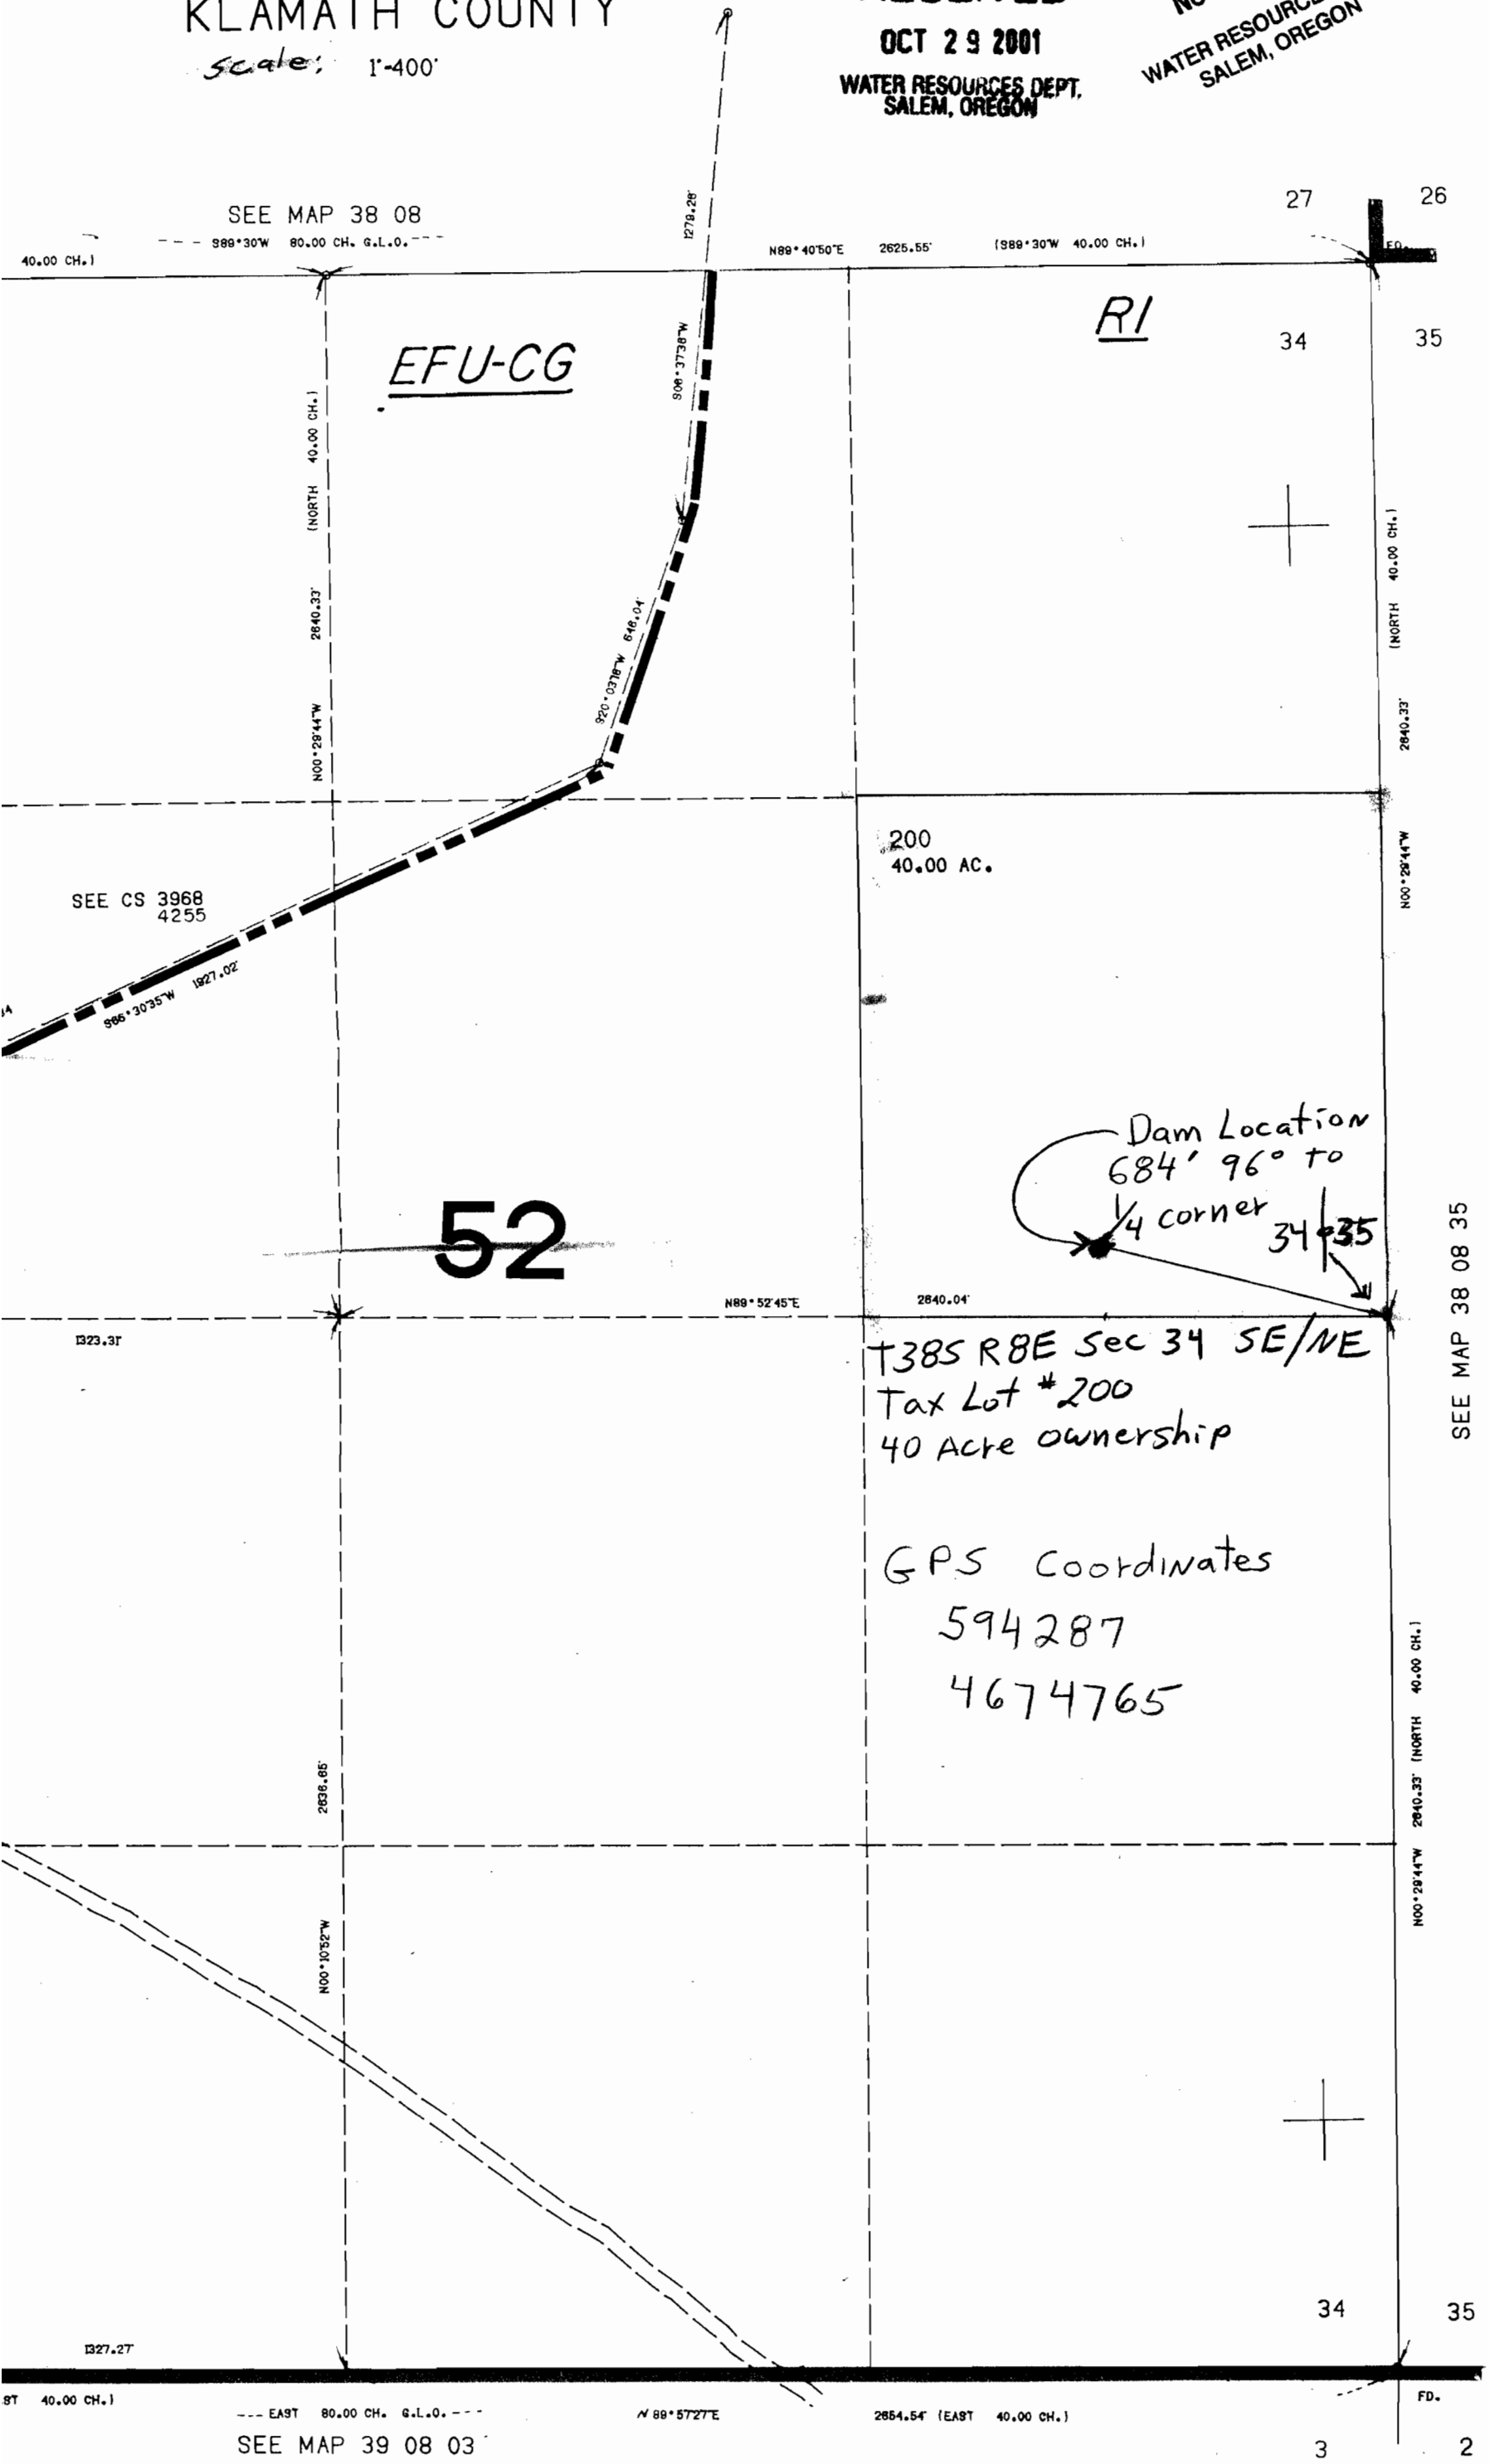

Application No. R-81741
Permit No. R12182