

4 2E 27


SECTION 27 T4S R2E. WM.

INDEX

CLACKAMAS COUNTY

one lot structure of 1"=400' (1"=800') (map reduced by 1/2 at assessors office)
cancelled tax lots
1400 New 2000
2500 New 2000
2500 New 2000
400
1290
1295

This map was prepared for assessment purposes only.

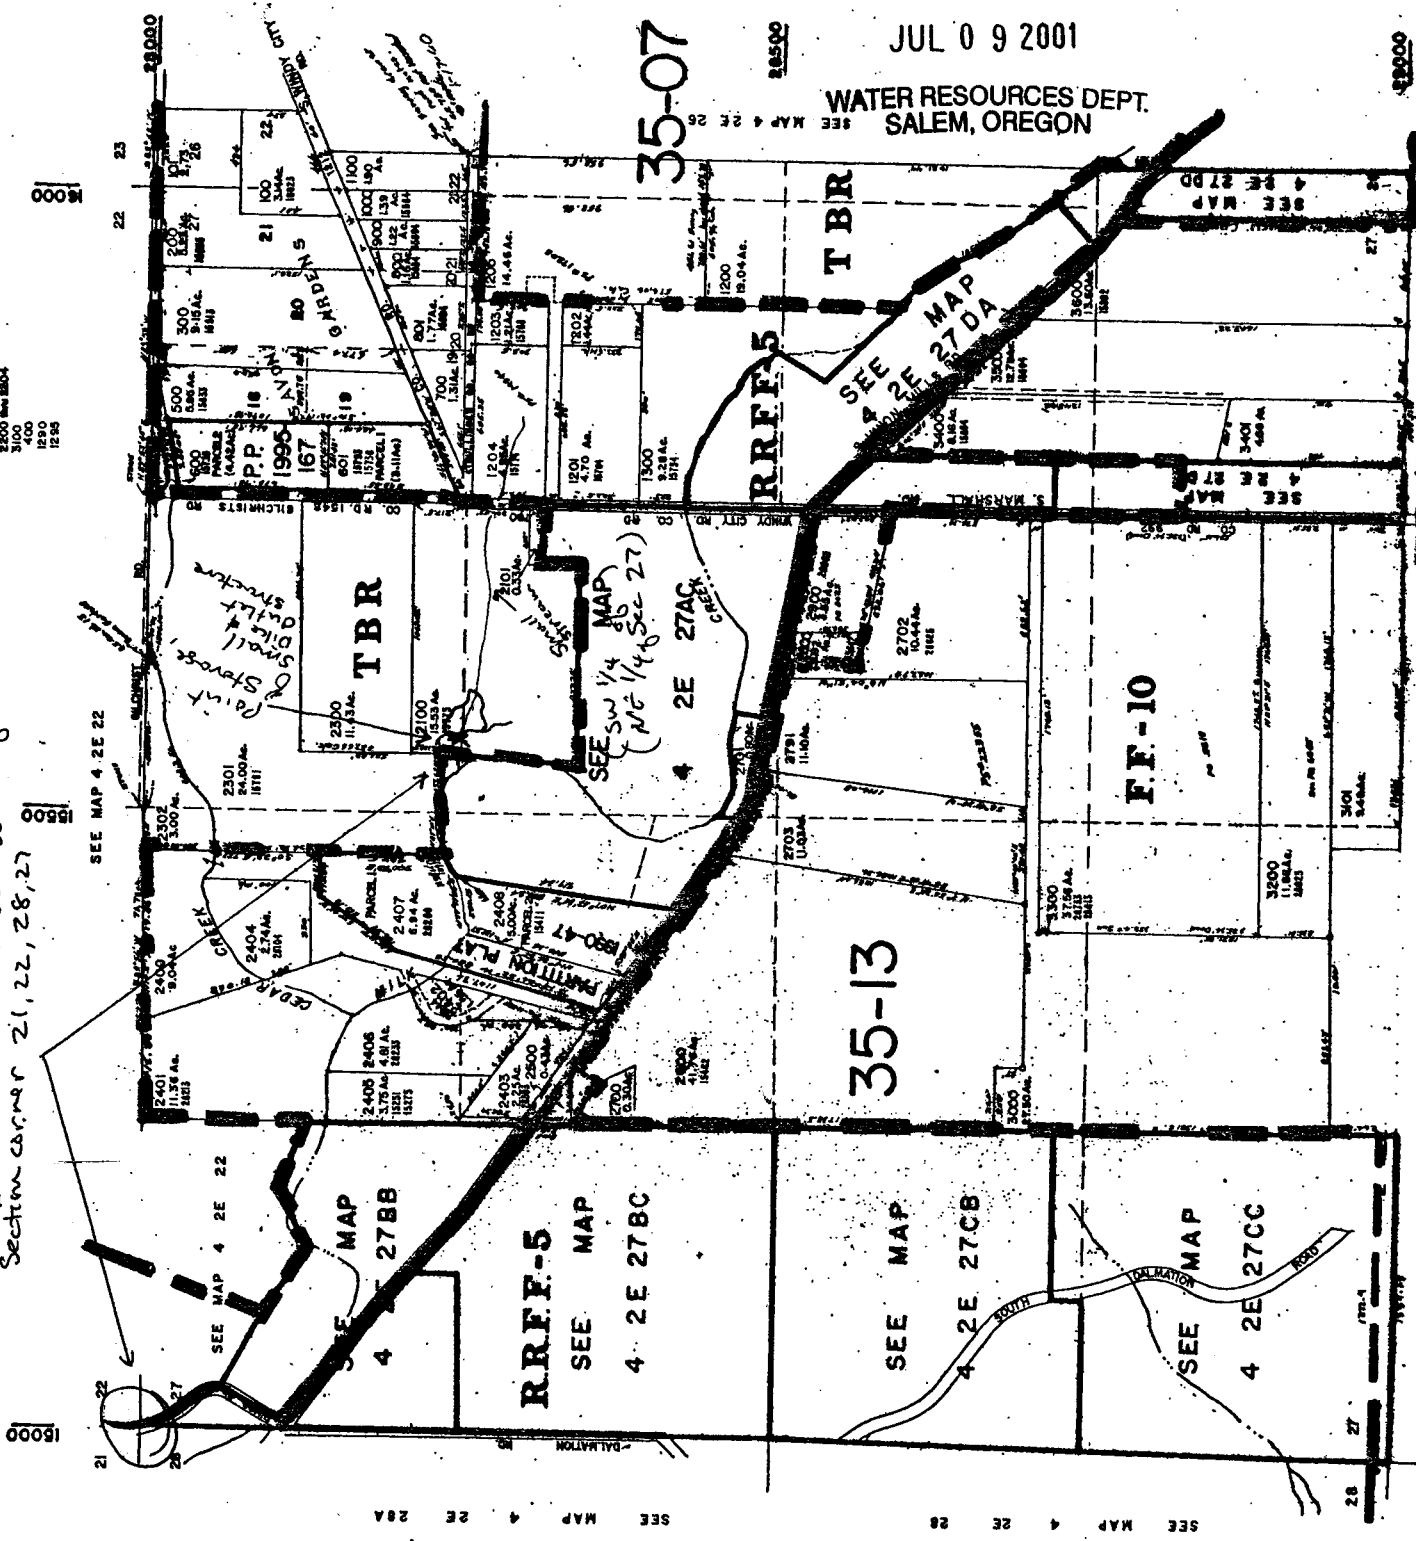

RECEIVED

JUL 09 2001

WATER RESOURCES DEPT.
SALEM, OREGON

Application No. R-84799
Permit No. R-13248

RECEIVED

MAR 13 2003

WATER RESOURCES DEPT.
SALEM, OREGON