


G-3471

RECEIVED

NOV 18 2002

WATER RESOURCES DEPT.
SALEM, OREGON

T.8S.R.39E.W.M.

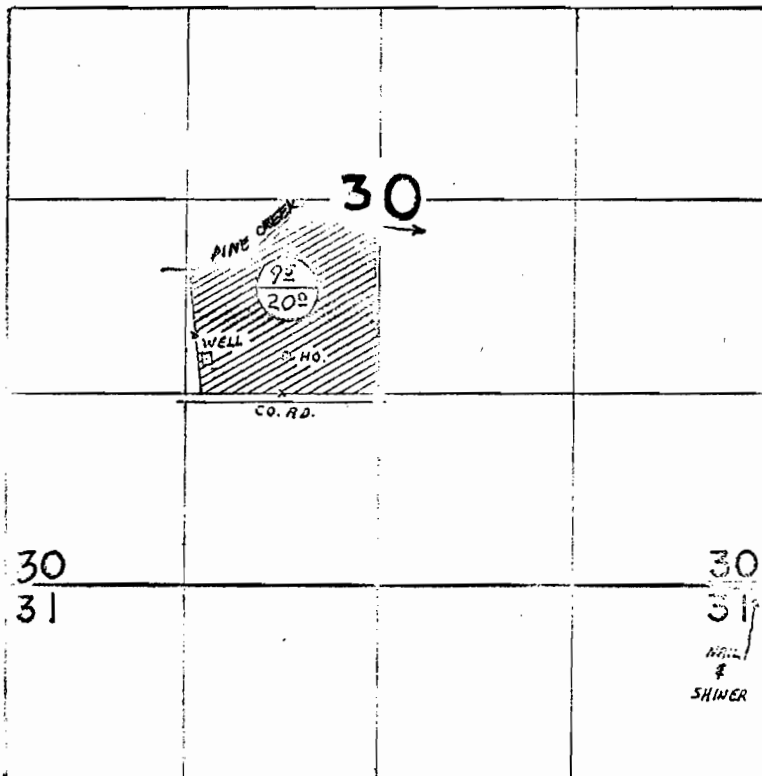

WELL LOC. 1550' N. & 3810' W. FROM SE COR. SEC. 30



PRIMARY
SUPPLEMENTAL CERT. - 3763

RECEIVED

MAR 26 2003

WATER RESOURCES DEPT.
SALEM, OREGON

FINAL PROOF SURVEY

UNDER

Application No. G-3722 Permit No. G-3471

IN NAME OF

RONALD E. JOHNSON

Surveyed JULY 9 1970, by L.E. GOULD

app # R-85344
Permit # R-13546