

T 34S R 6W S 36

Prepared for  
purpose only.

RECEIVED

RECEIVED

NOV 15 2001

SEP 20 1999


WATER RESOURCES DEPT  
SALEM, OREGON

WATER RESOURCES DEPT.  
SALEM, OREGON

SEE MAP 34

N ↑

1" = 400'

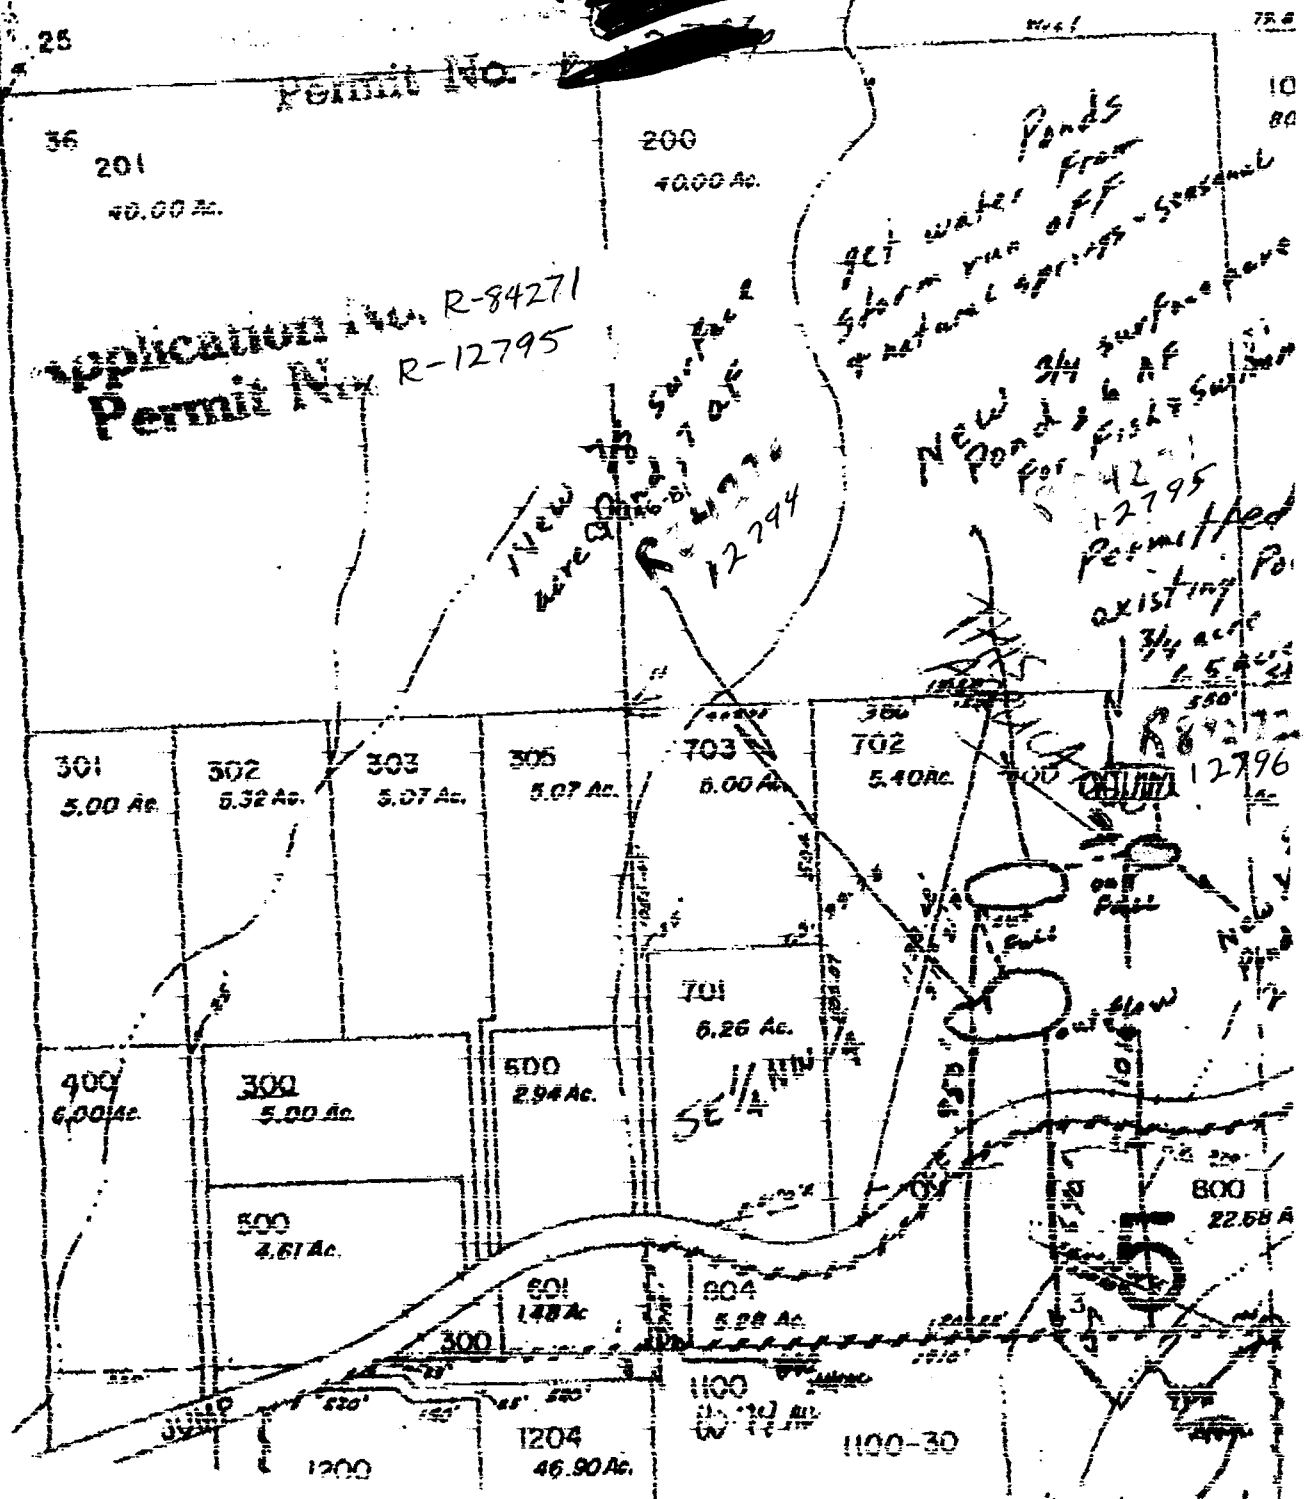

2 1/2 AF  
5 out 36