

UNITED STATES  
DEPARTMENT OF THE INTERIOR  
BUREAU OF LAND MANAGEMENT


SECTION

17

# Oregon State Water Filings

TOWNSHIP 9S, RANGE 42E, W. M.

North

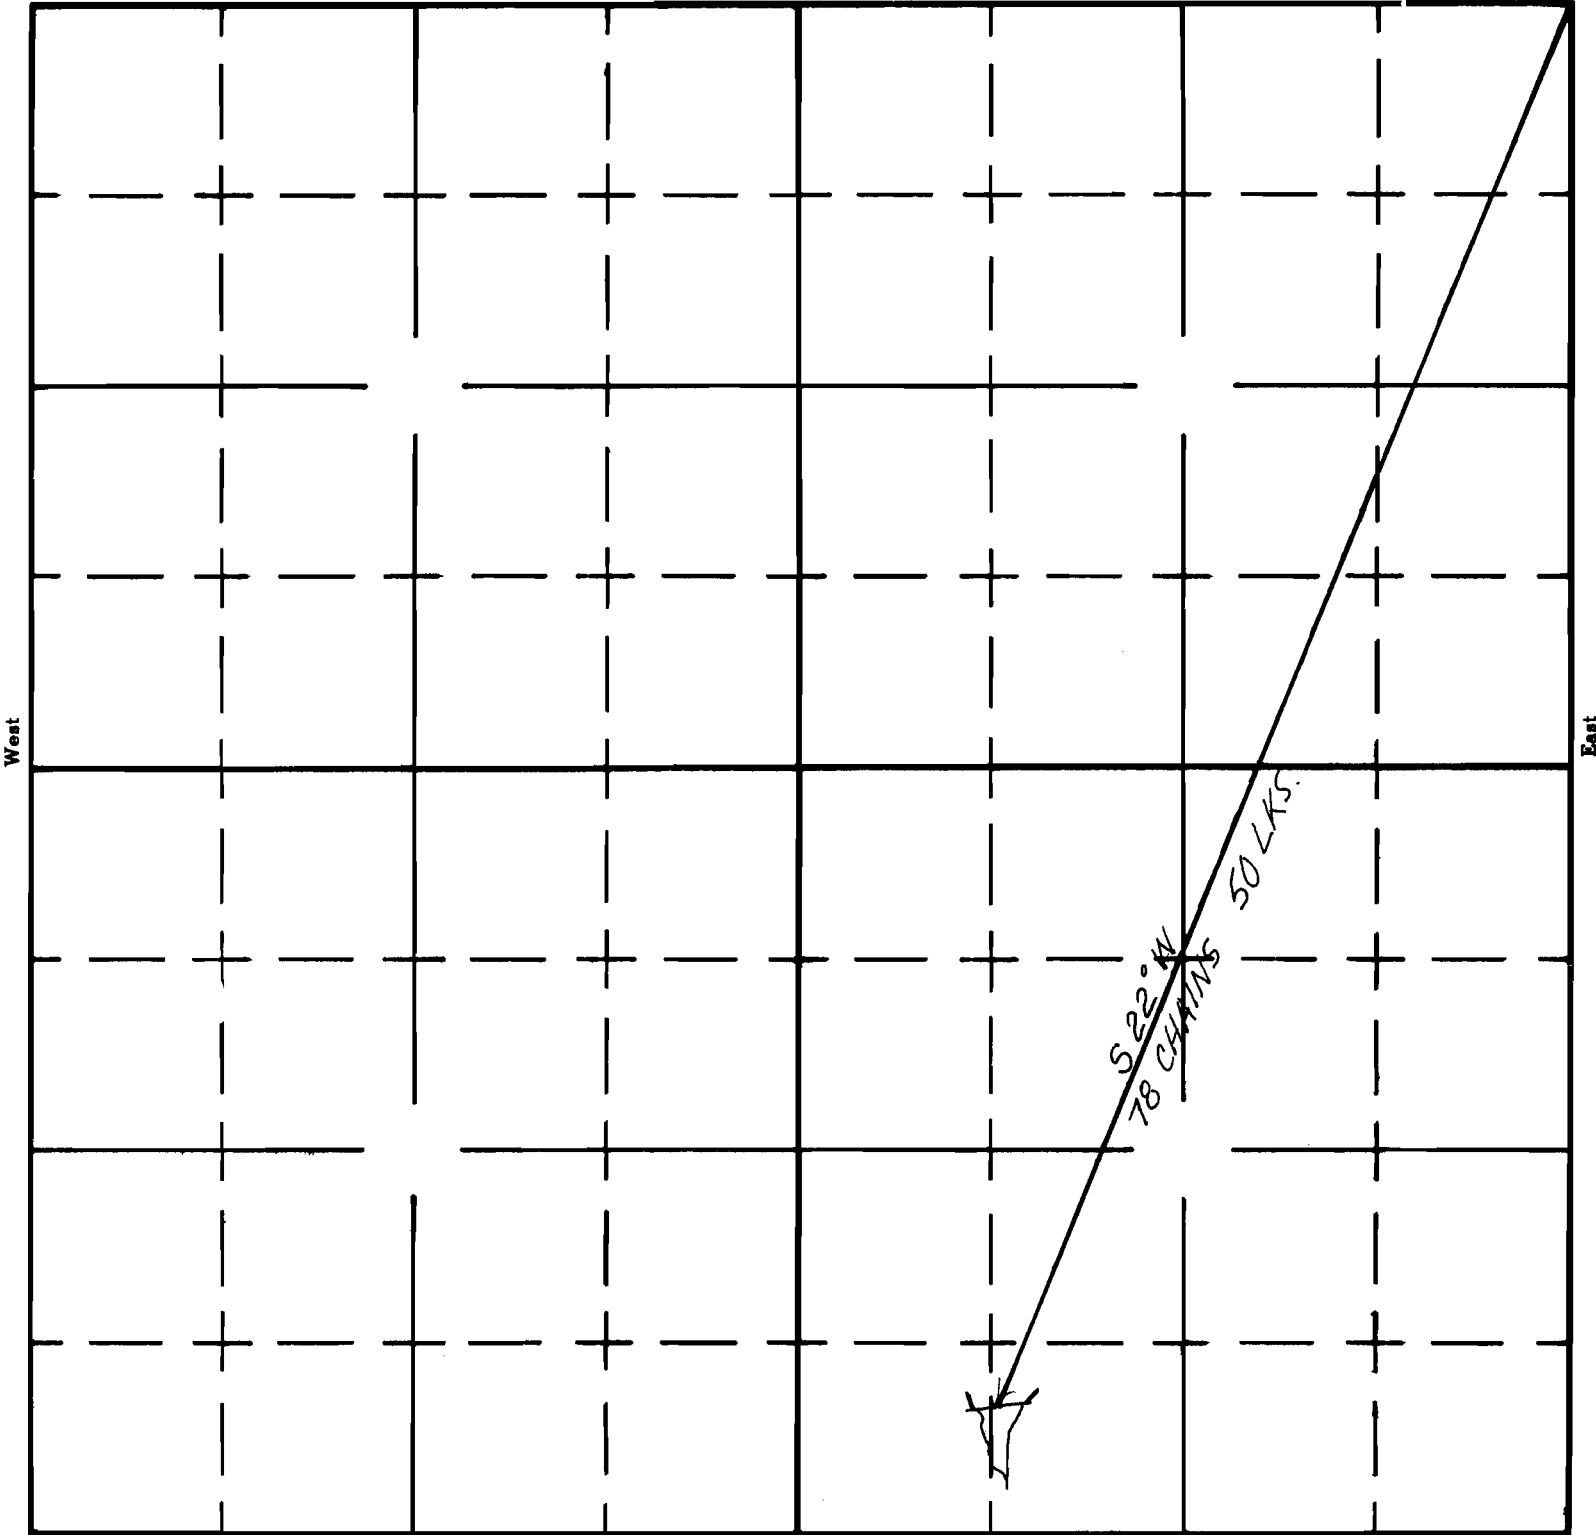

Application No. R-34295  
Permit No. R-2509

APPLICATION No.  
PERMIT No.