

UNITED STATES
DEPARTMENT OF THE INTERIOR
BUREAU OF LAND MANAGEMENT


SECTION

5

Oregon State Water Filings

TOWNSHIP 9S, RANGE 42E, W. M.

North

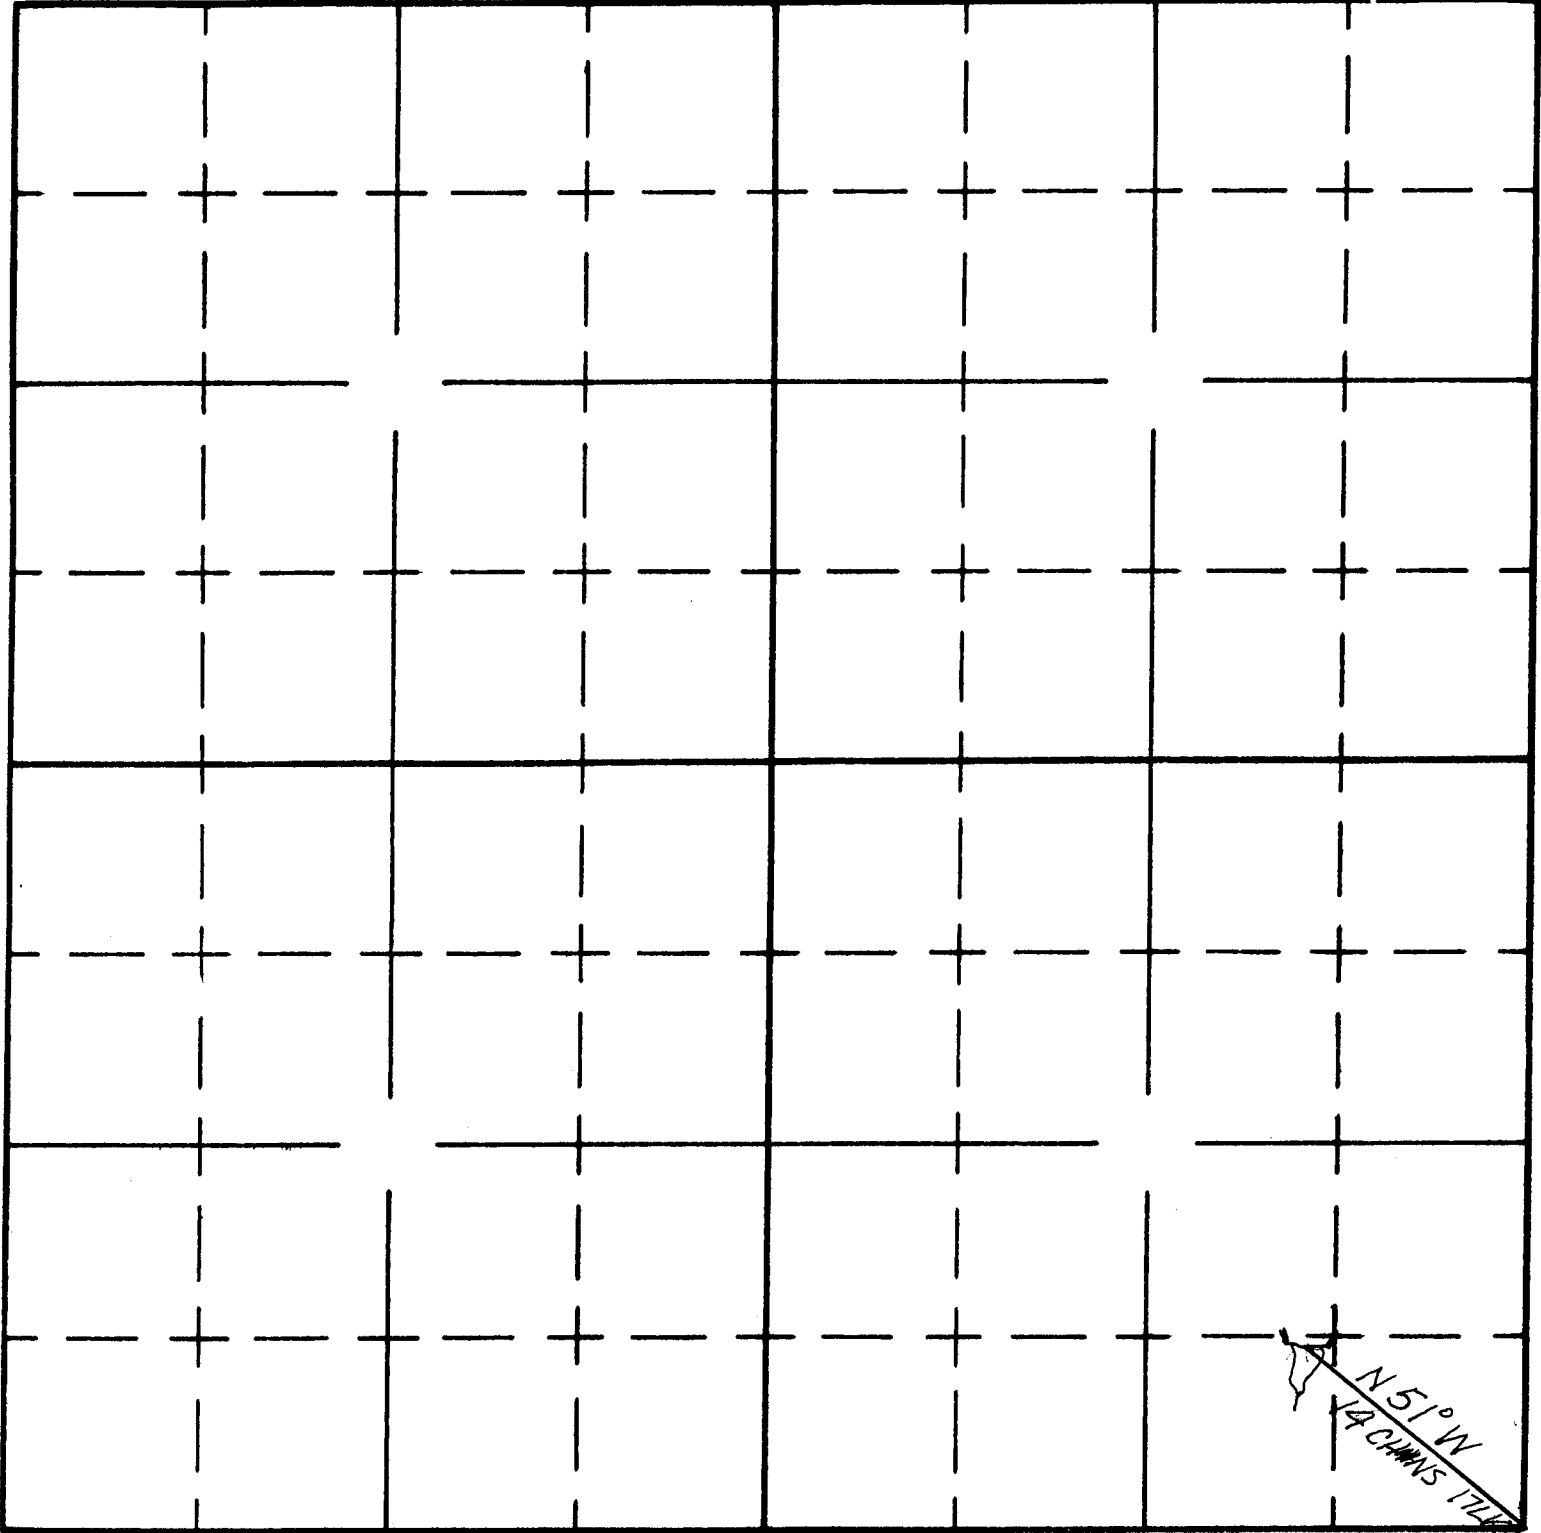

South

Application No, R-34296
Permit No, R-2510

APPLICATION No.
PERMIT No.