

UNITED STATES
DEPARTMENT OF THE INTERIOR
BUREAU OF LAND MANAGEMENT


SECTION

4

Oregon State Water Filings

TOWNSHIP 9S, RANGE 42E, W. M.

North

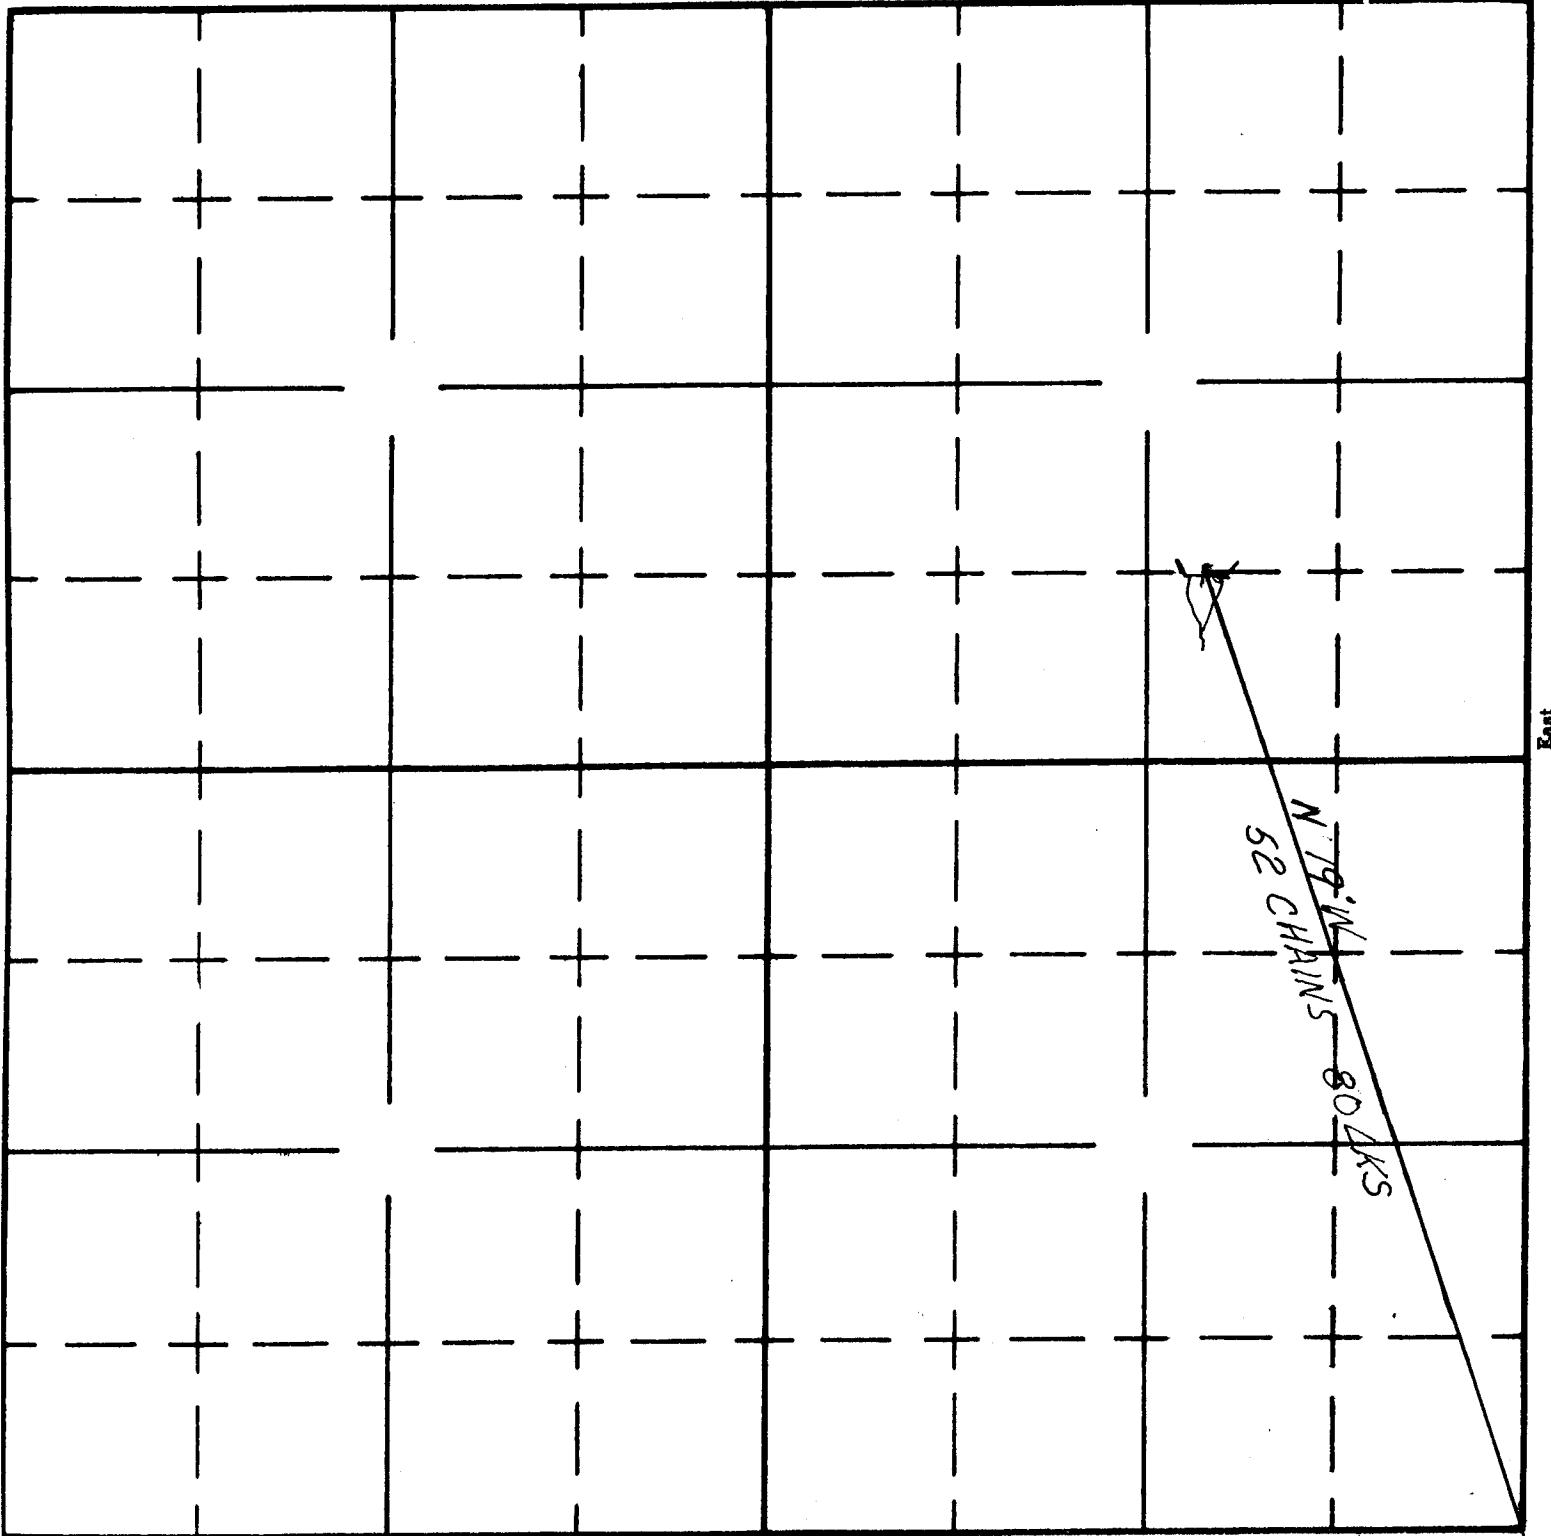

South

Application No. R-34297
Permit No. R-2571

APPLICATION No.
PERMIT No.