

Form A1-187
March 1961

UNITED STATES
DEPARTMENT OF THE INTERIOR
BUREAU OF LAND MANAGEMENT


5-27-62
JAN 28 1962
STATE ENGINEER
SELEM OREGON

SECTION

19

Oregon State Water Filings

TOWNSHIP 12 S., RANGE 41 E., W. M.

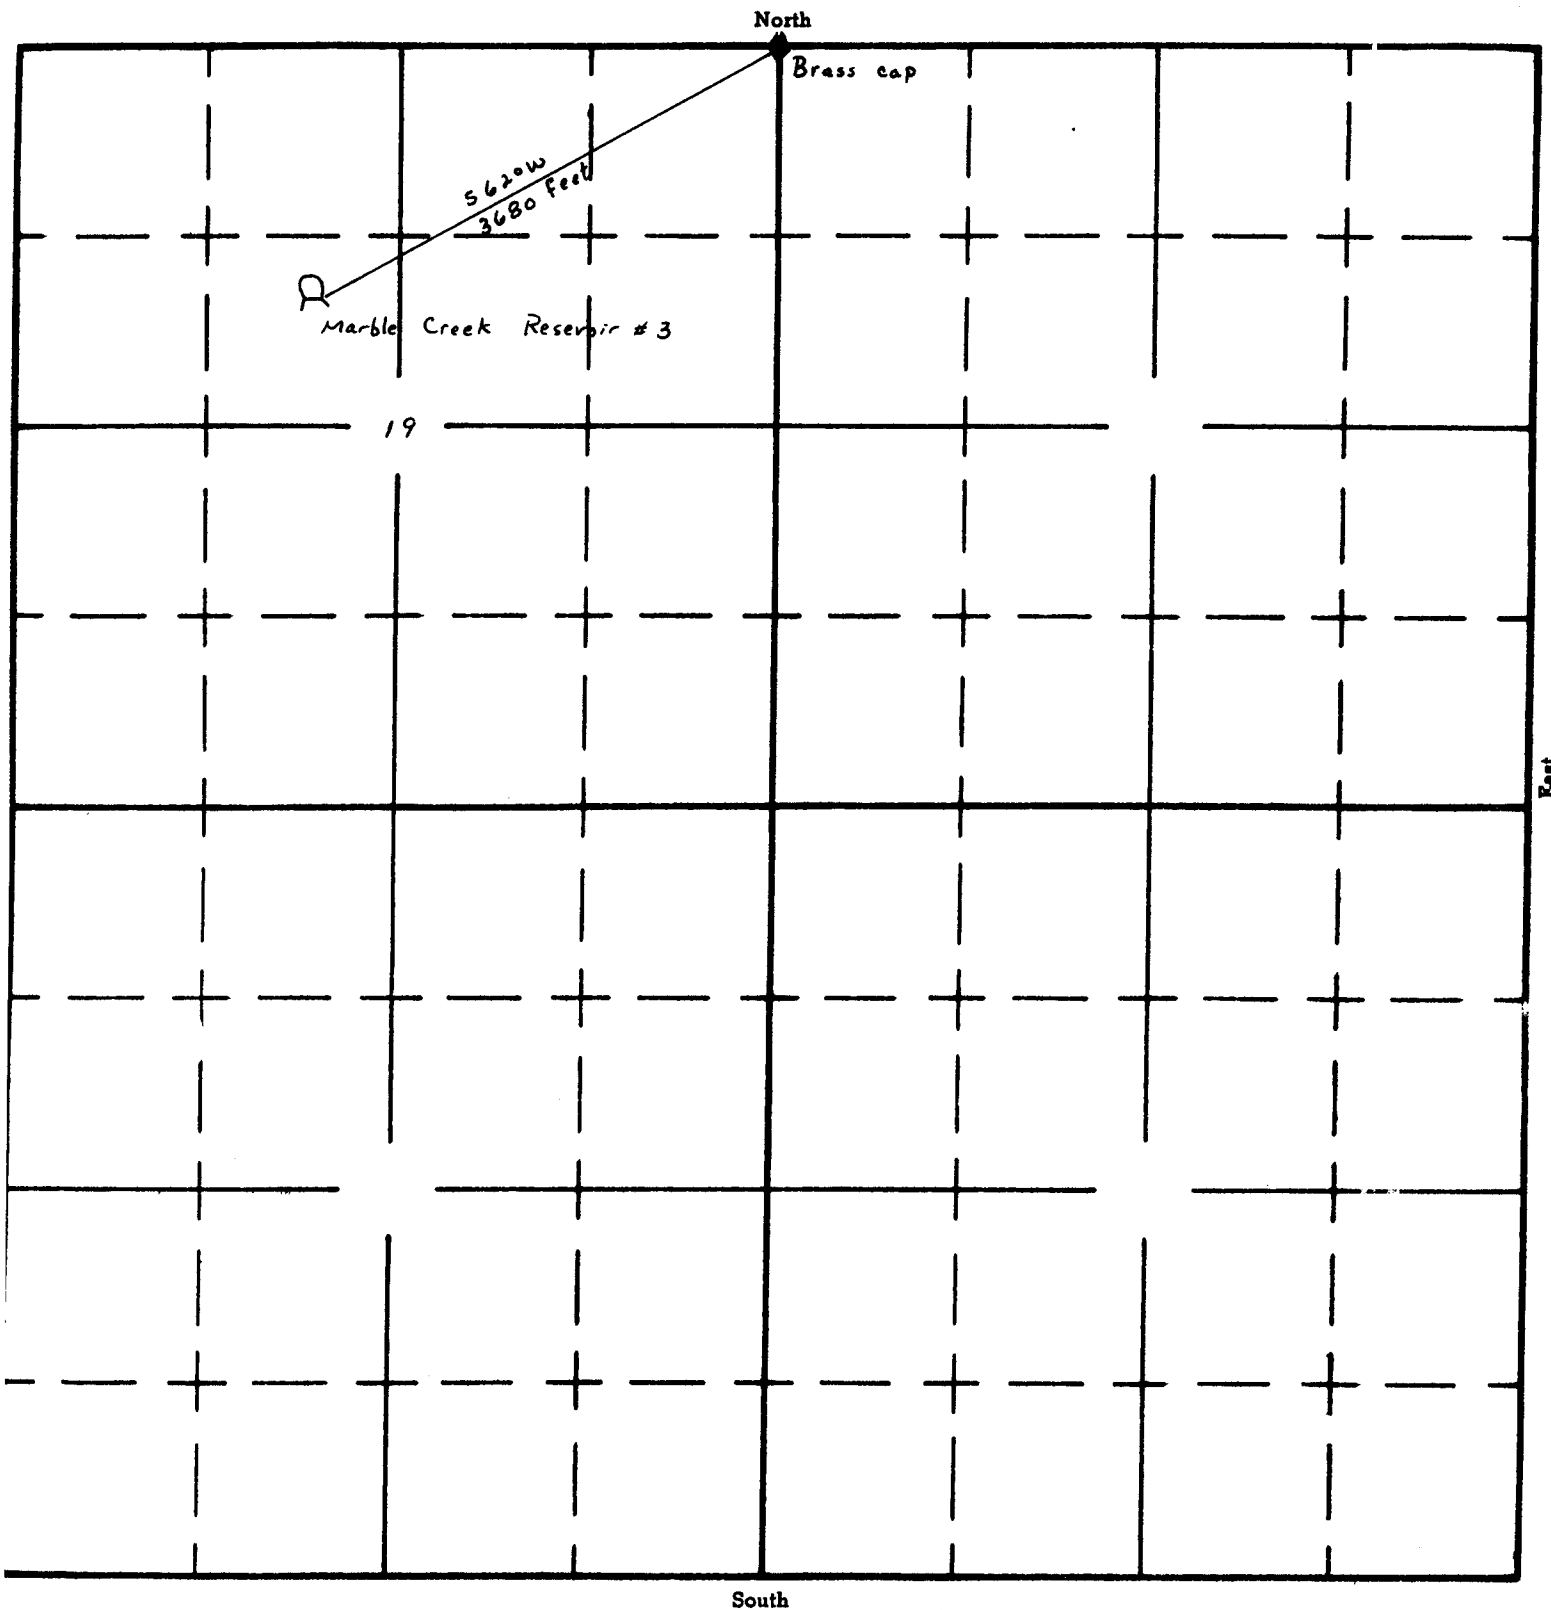

South

APPLICATION No. R-37338
PERMIT No. R-2726