


UNITED STATES
DEPARTMENT OF THE INTERIOR
BUREAU OF LAND MANAGEMENT

SECTION 33

Oregon State Water Filings

1-C-202

TOWNSHIP 85, RANGE 47E, W. M.

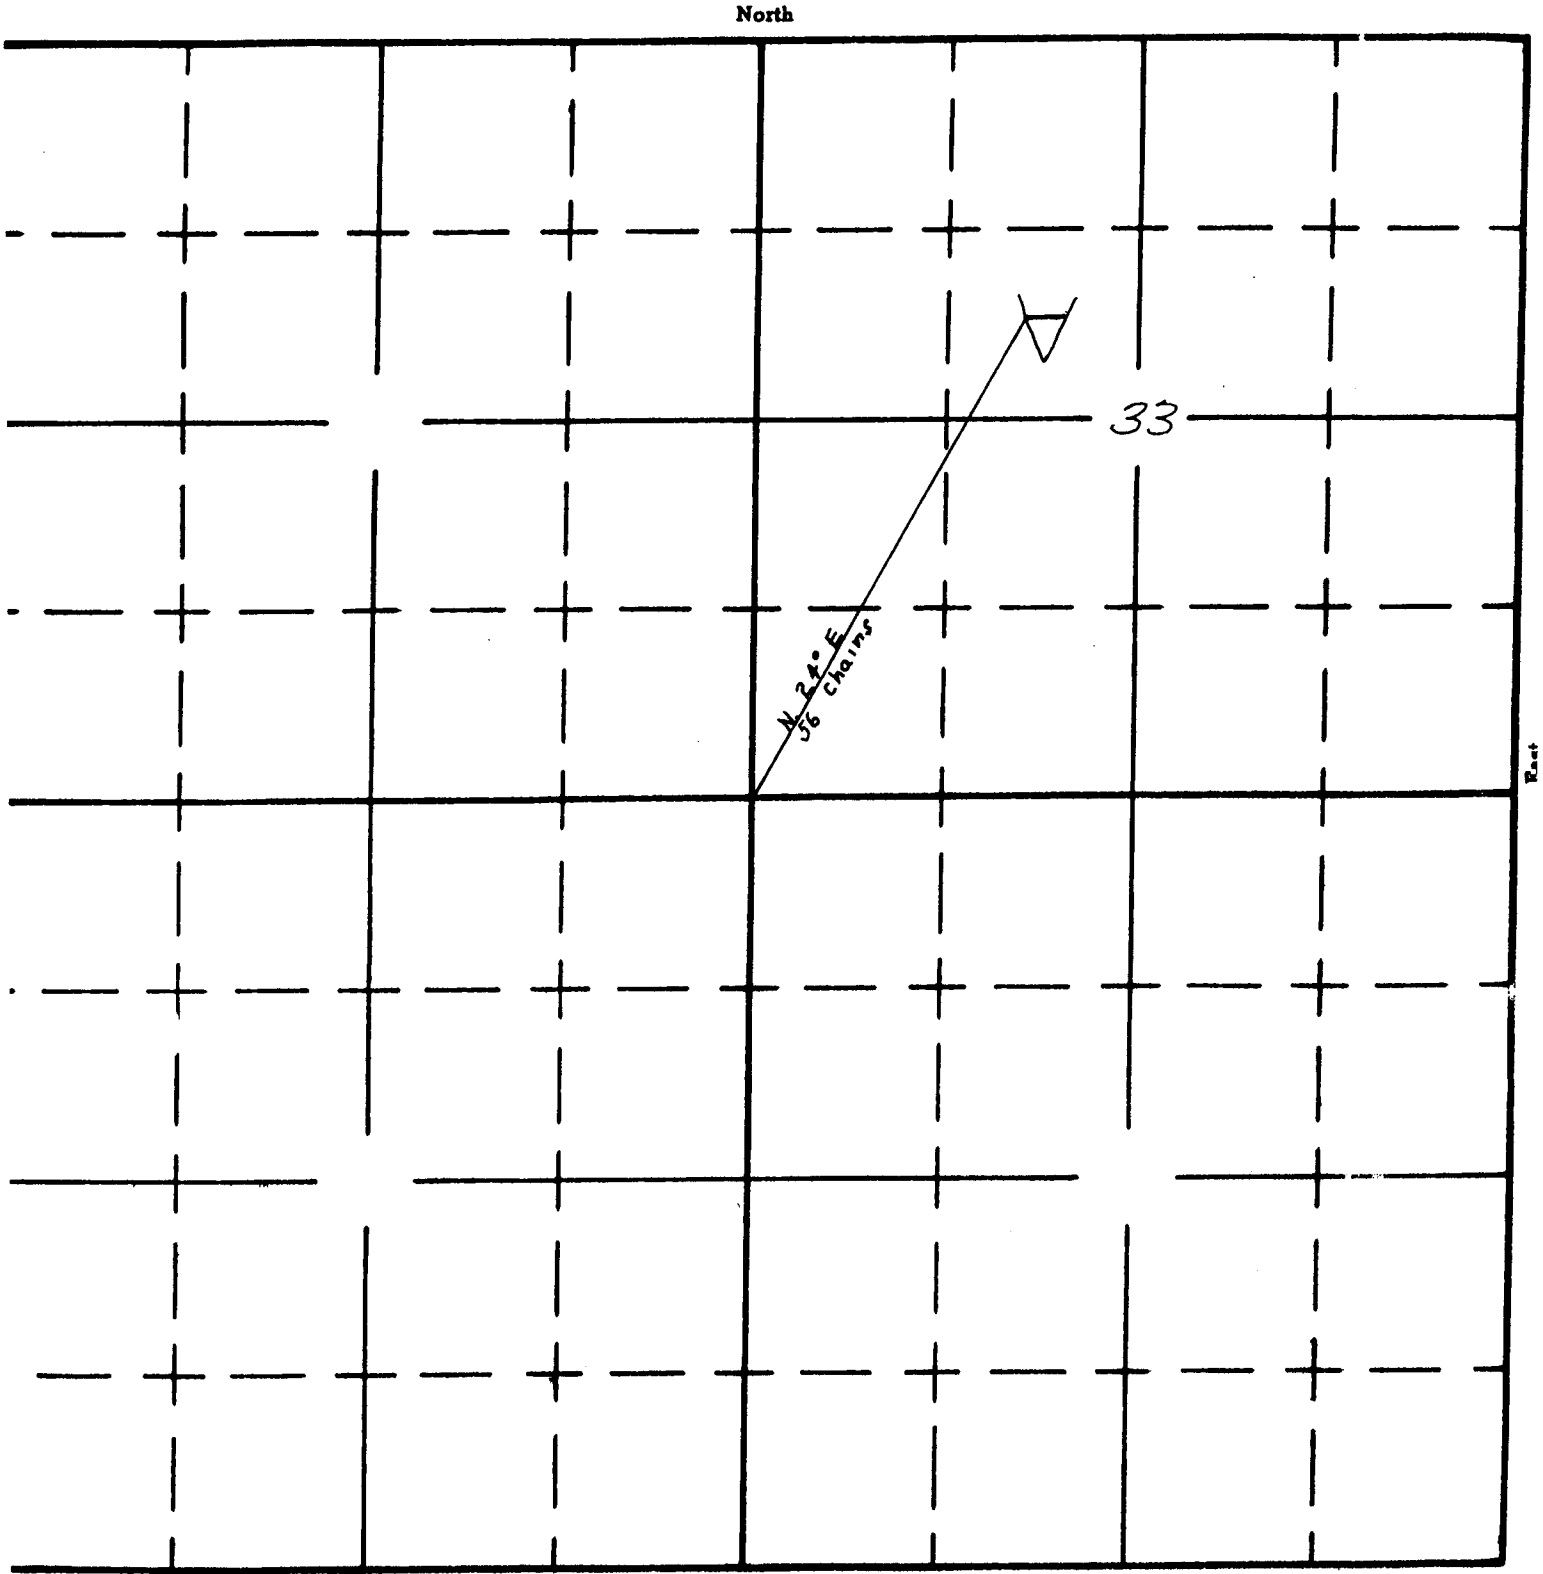

South

APPLICATION No. R-38274
PERMIT No. R-3218