

Form A1-187
March 1961

UNITED STATES
DEPARTMENT OF THE INTERIOR
BUREAU OF LAND MANAGEMENT

SECTION


23

Oregon State Water Filings

TOWNSHIP 10S, RANGE 42E, W. M.

0-6-246

North

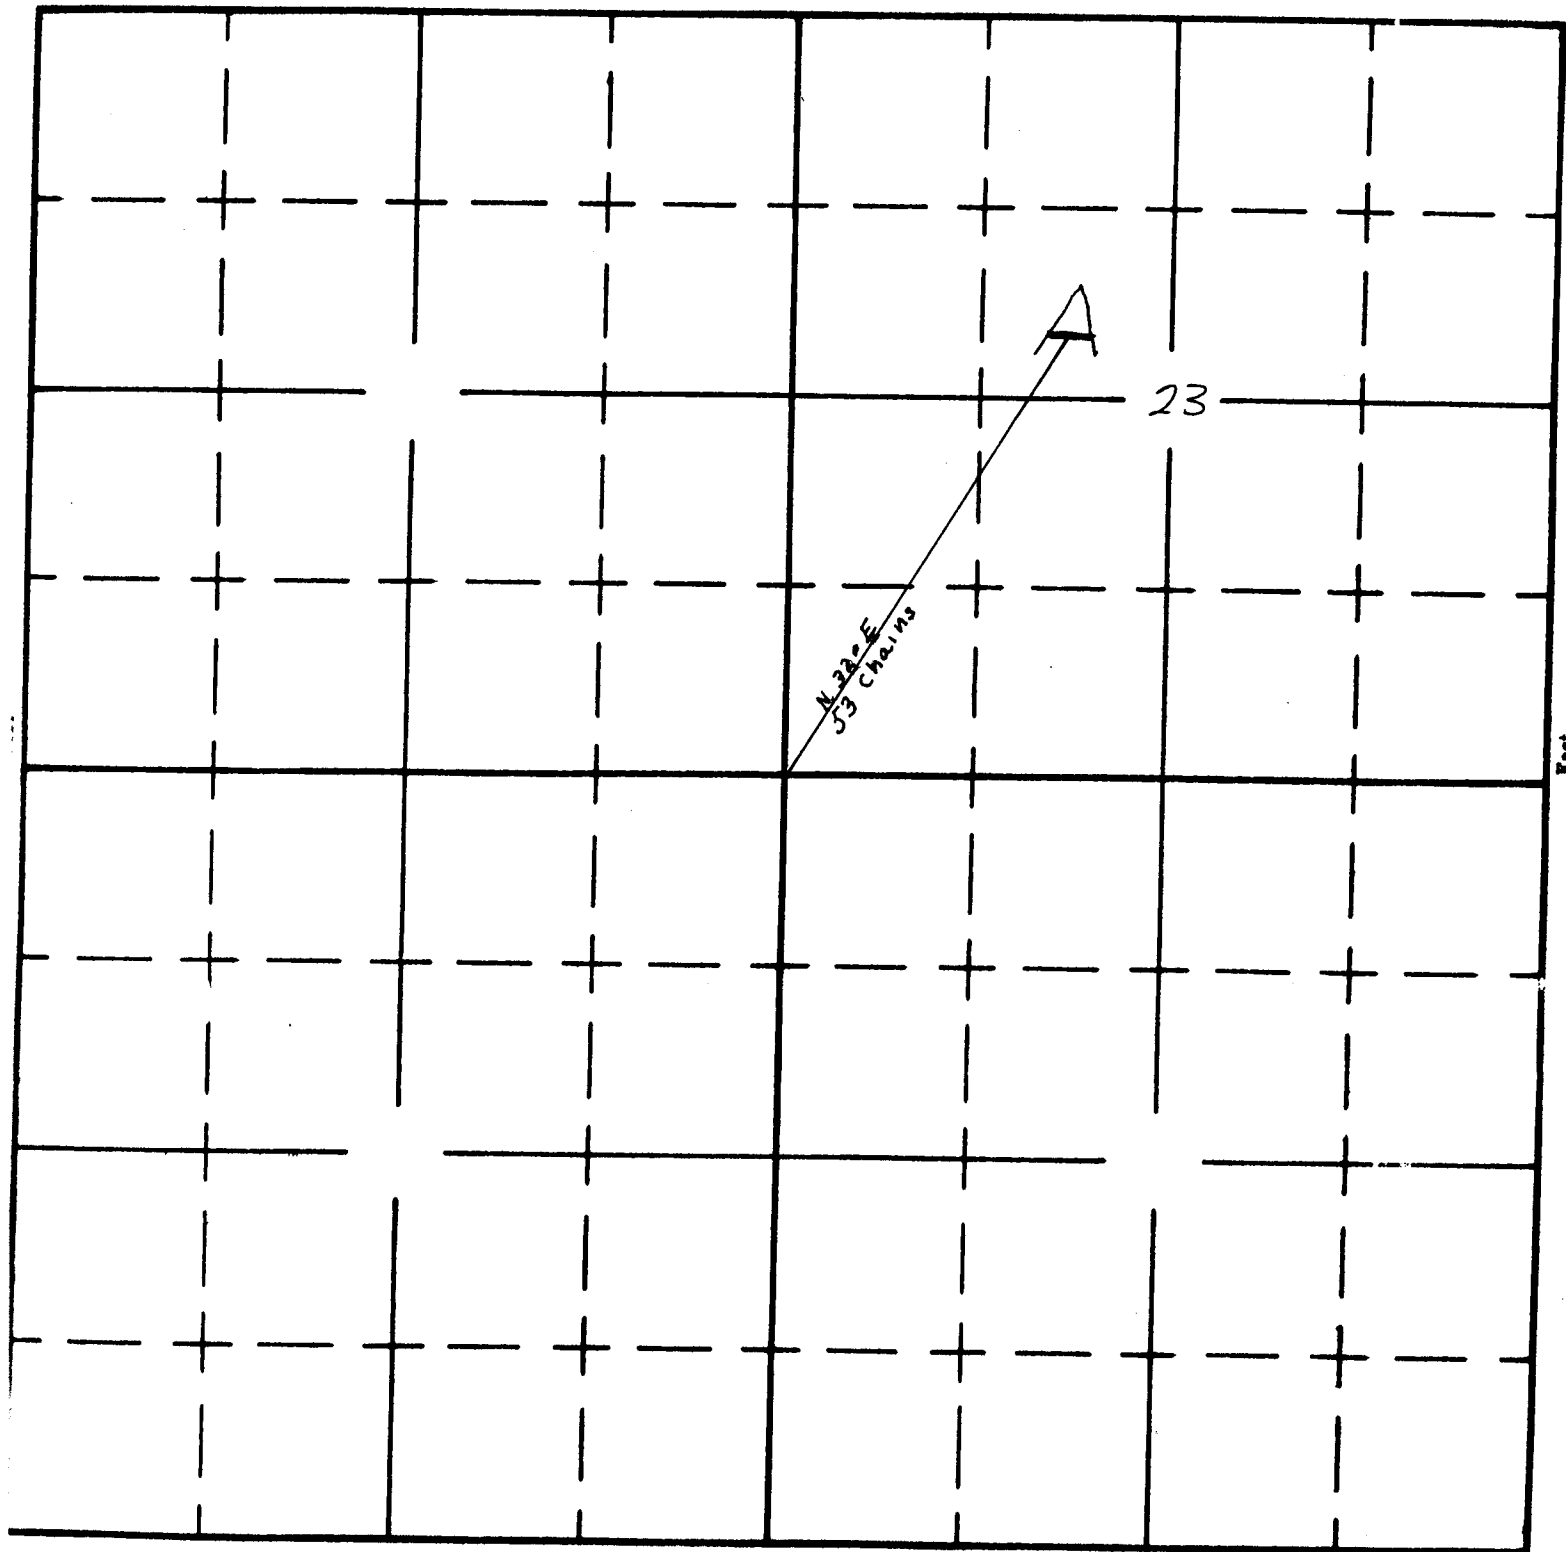

South

APPLICATION No. A-38275
DEFLT. N. R-3219